


STATE OF KANSAS
STATE CORPORATION COMMISSION

Give All Information Completely
Make Required Affidavit
Mail or Deliver Report to:
Conservation Division
State Corporation Commission
211 No. Broadway
Wichita, Kansas

15-137-00002-00-00

WELL PLUGGING RECORD

NORTH

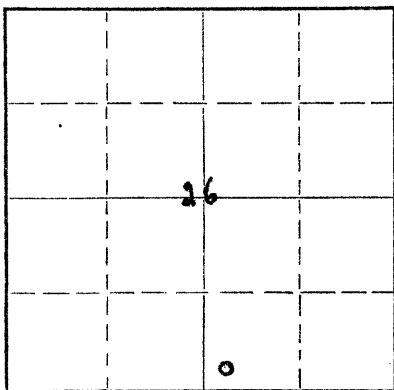

Locate well correctly on above
Section Plat

Norton County, Sec. 26 Twp. 5S Rge. 22 (X) W (W)
Location as "NE/CNW%SW%" or footage from lines SW $\frac{1}{4}$ SW $\frac{1}{4}$ SE $\frac{1}{4}$
Lease Owner Antry & Warren
Lease Name T. R. McKinley, Inc. Well No. 1
Office Address 15 West 4th St., Tulsa 3, Okla.
Character of Well (completed as Oil, Gas or Dry Hole) Dry hole
Date well completed April 28 19 62
Application for plugging filed May 1 19 62
Application for plugging approved April 28 19 62
Plugging commenced April 28 19 62
Plugging completed April 30 19 62
Reason for abandonment of well or producing formation Dry Hole

If a producing well is abandoned, date of last production 19
Was permission obtained from the Conservation Division or its agents before plugging was commenced? yes - Mr. Eldon Petty

Name of Conservation Agent who supervised plugging of this well Eldon Petty
Producing formation none Depth to top Bottom Total Depth of Well 3780 Feet
Show depth and thickness of all water, oil and gas formations.

OIL, GAS OR WATER RECORDS

CASING RECORD

FORMATION	CONTENT	FROM	TO	SIZE	PUT IN	PULLED OUT
Drilled As Dry Hole						

Describe in detail the manner in which the well was plugged, indicating where the mud fluid was placed and the method or methods used in introducing it into the hole. If cement or other plugs were used, state the character of same and depth placed, from 0 feet to 3780 feet for each plug set.

3780 to 550- filled with 43 viscosity mud;
550- set Halliburton Plug and placed 20 sacks of cement on plug through drill pipe and filled with 43 viscosity mud;
At 180 feet spotted 20 sacks of cement and filled with 43 viscosity mud;
At 35 feet placed Halliburton Plug and filled to top of surface casing and in cellar with 8 sacks of cement.

RECEIVED
STATE CORPORATION COMMISSION
MAY 3 1962
CONSERVATION DIVISION
Wichita, Kansas

(If additional description is necessary, use BACK of this sheet)

Name of Plugging Contractor Interstate Drilling Co. 5-3-62
Address 15 West 4th Street, Tulsa 3, Oklahoma

STATE OF Oklahoma, COUNTY OF Tulsa, ss.
(employee of owner) or (owner or operator) of the above-described well, being first duly sworn on oath, says: That I have knowledge of the facts, statements, and matters herein contained and the log of the above-described well as filed and that the same are true and correct. So help me God.

(Signature) [Signature]
15 West 4th Street, Tulsa, Oklahoma.
(Address)

SUBSCRIBED AND SWORN TO before me this 1st day of May, 19 62

My Commission Expires October 15, 1965
My commission expires
Laron Rubin
Notary Public.

