


15-137-20090-00-00

STATE OF KANSAS  
STATE CORPORATION COMMISSION

Give All Information Completely  
Make Required Affidavit  
Mail or Deliver Report to:  
Conservation Division  
State Corporation Commission

P. O. Box 17027  
Wichita, Kansas 67217  
NORTH

WELL PLUGGING RECORD

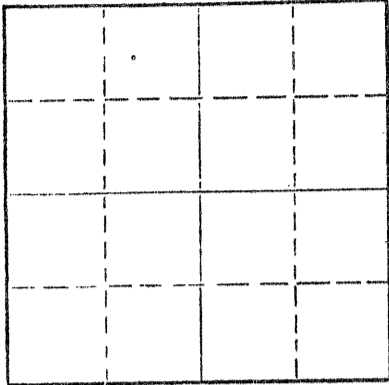

Locate well correctly on above  
Section Plat

Norton County. Sec. 15 Twp. 5S Rge. (E) 23 (W)  
Location as "NE/CNW/SW" or footage from lines SE SW SW  
Lease Owner Abercrombie Drilling, Inc.  
Lease Name HILDEBRAND Well No. 1  
Office Address 801 Union Center, Wichita, Kansas 67202  
Character of Well (completed as Oil, Gas or Dry Hole) Dry Hole  
Date well completed January 26, 1974  
Application for plugging filed (verbally) January 26, 1974  
Application for plugging approved (verbally) January 26, 1974  
Plugging commenced January 26, 1974  
Plugging completed January 26, 1974  
Reason for abandonment of well or producing formation Dry Hole

If a producing well is abandoned, date of last production 19  
Was permission obtained from the Conservation Division or its agents before plugging was commenced? Yes

Name of Conservation Agent who supervised plugging of this well Bill Nichols  
Producing formation Depth to top Bottom Total Depth of Well 3600 Feet  
Show depth and thickness of all water, oil and gas formations.

OIL, GAS OR WATER RECORDS

CASING RECORD

FORMATION	CONTENT	FROM	TO	SIZE	PUT IN	PULLED OUT

Describe in detail the manner in which the well was plugged, indicating where the mud fluid was placed and the method or methods used in introducing it into the hole. If cement or other plugs were used, state the character of same and depth placed, from feet to feet for each plug set.

1st plug set at 975' w/72 cu. ft. cement  
2nd plug set at 245' w/30 cu. ft. cement  
3rd plug set at 40' w/10 cu. ft. cement  
Plug down at 7:00 a.m. 1-26-74

RECEIVED  
STATE CORPORATION COMMISSION

JAN 30 1974

CONSERVATION DIVISION  
Wichita, Kansas

1-30-74

(If additional description is necessary, use BACK of this sheet)  
Name of Plugging Contractor Abercrombie Drilling, Inc.  
Address 801 Union Center, Wichita, Kansas 67202

STATE OF KANSAS, COUNTY OF SEDGWICK, ss.

Jerry A. Langrehr (employee of owner) or (owner or operator) of the above-described well, being first duly sworn on oath, says: That I have knowledge of the facts, statements, and matters herein contained and the log of the above-described well as filed and that the same are true and correct. So help me God.

(Signature)

801 Union Center, Wichita, Kansas 67202  
(Address)

SUBSCRIBED AND SWORN TO before me this 28th day of January, 1974

My commission expires

February 10, 1975

Beverly Mann  
Beverly Mann

Notary Public.