


STATE OF KANSAS
STATE CORPORATION COMMISSION

Give All Information Completely
Make Required Affidavit
Mail or Deliver Report to:
Conservation Division
State Corporation Commission
211 No. Broadway
Wichita, Kansas

WELL PLUGGING RECORD

15-137-60256-00-00

NORTH

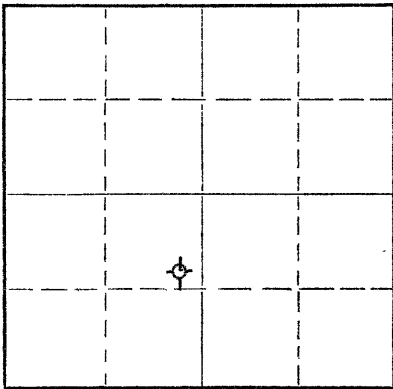

Locate well correctly on above
Section Plat

NORTON County. Sec. 2 Twp. 5 Rge. 22 (E) W (W)
Location as "NE/CNW/SW" or footage from lines SE NE SW
Lease Owner D. G. HANSEN & C-G DRILLING CO.
Lease Name WALTERS Well No. 1
Office Address 107 RULE BLDG., WICHITA, KANSAS
Character of Well (completed as Oil, Gas or Dry Hole) DRY HOLE
Date well completed APRIL 28 1956
Application for plugging filed APRIL 28 1956
Application for plugging approved APRIL 28 1956
Plugging commenced APRIL 29 1956
Plugging completed APRIL 29 1956
Reason for abandonment of well or producing formation TOO LOW STRUCTUALLY

If a producing well is abandoned, date of last production 19
Was permission obtained from the Conservation Division or its agents before plugging was commenced? YES

Name of Conservation Agent who supervised plugging of this well ELDON PETTY, HAYS, KANSAS
Producing formation _____ Depth to top _____ Bottom _____ Total Depth of Well 3596 Feet
Show depth and thickness of all water, oil and gas formations.

OIL, GAS OR WATER RECORDS

CASING RECORD

FORMATION	CONTENT	FROM	TO	SIZE	PUT IN	PULLED OUT
				8-5/8"	163'	none

Describe in detail the manner in which the well was plugged, indicating where the mud fluid was placed and the method or methods used in introducing it into the hole. If cement or other plugs were used, state the character of same and depth placed, from _____ feet to _____ feet for each plug set.

Filled hole with heavy mud to 178'.
Set plug. Put in 1/2 sack Hulls
and 15 sacks of cement. Filled with
heavy mud up to 40'. Set plug.
Filled to top with 1/2 sack Hulls
and 10 sacks of cement.

(If additional description is necessary, use BACK of this sheet)

Name of Plugging Contractor C-G DRILLING CO.
Address 107 RULE BLDG., WICHITA, KANSAS

STATE OF KANSAS, COUNTY OF SEDGWICK, ss.
Jay H. Galloway (employee of owner) or (owner or operator) of the above-described well, being first duly sworn on oath, says: That I have knowledge of the facts, statements, and matters herein contained and the log of the above-described well as filed and that the same are true and correct. So help me God.

(Signature)

Jay H. Galloway
107 Rule Bldg.

(Address)

SUBSCRIBED AND SWORN TO before me this 30th day of April, 1956

My commission expires May 20, 1959

Vicky Jacobs
Vicky Jacobs

Notary Public.

PLUGGING
FILE SEC 2 T 5 R 22W
BOOK PAGE 57 LINE 34

RECEIVED
STATE CORPORATION COMMISSION
MAY 22 1956
CONSERVATION DIVISION
Wichita, Kansas

52-56