

WELL PLUGGING RECORD

OR


FORMATION PLUGGING RECORD

Strike out upper line when reporting plugging off formations.

STATE OF KANSAS
STATE CORPORATION COMMISSION

Give All Information Completely
Make Required Affidavit
Mail or Deliver Report to:
Conservation Division
State Corporation Commission
800 Bittling Building
Wichita, Kansas

NORTH

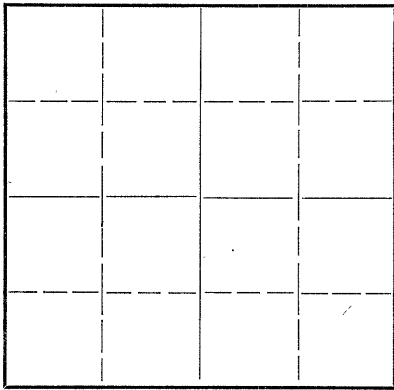

Locate well correctly on above
Section Plat

Norton County, Sec. 6 Twp. 5 Rge. (E) 22 (W)
Location as "NE $\frac{1}{4}$ NW $\frac{1}{4}$ SW $\frac{1}{4}$ " or footage from lines 330'S 330'W from North $\frac{1}{4}$ Corner
Lease Owner Cities Service Oil Company
Lease Name B.M.A. Well No. 1
Office Address Bartlesville, Oklahoma.
Character of Well (completed as Oil, Gas or Dry Hole) Dry
Date well completed 10-26-42 19
Application for plugging filed 10-27-42 19
Application for plugging approved 10-27-42 19
Plugging commenced 10-27-42 19
Plugging completed 10-27-42 19
Reason for abandonment of well or producing formation

If a producing well is abandoned, date of last production 19
Was permission obtained from the Conservation Division or its agents before plugging was commenced? Yes Mr. C.T. Alexander

Name of Conservation Agent who supervised plugging of this well
Producing formation Arbuckle Lime Depth to top 3705' Bottom Total Depth of Well 3775' Feet
Show depth and thickness of all water, oil and gas formations.


OIL, GAS OR WATER RECORDS

CASING RECORD

Formation	Content	From	To	Size	Put In	Pulled Out
Arbuckle Lime	Dry			85/8"	315'	None

Describe in detail the manner in which the well was plugged, indicating where the mud fluid was placed and the method or methods used in introducing it into the hold. If cement or other plugs were used, state the character of same and depth placed, from feet to feet for each plug set.

Filled with heavy mud from TD 3775' to 300' set wood plug
dumped 15 sacks cement mud to 30' set wood plug dumped 15 sacks cement
mud & dirt to surface.

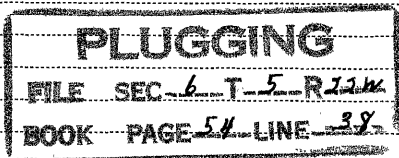

(If additional description is necessary, use BACK of this sheet)

Correspondence regarding this well should be addressed to Mr. R.C. Hauber
Address Cities Service Oil Co. Great Bend, Kansas. 11-21-42

STATE OF Kansas, COUNTY OF Barton, SS.
Mr. J.A. Cleverley (employee of owner) or (owner/operator) of the above-described well,
being first duly sworn on oath, says: That I have knowledge of the facts, statements and matters herein contained and the log of the above-described well as filed and that the same are true and correct. So help me God.

(Signature) J.A. Cleverley
Cities Service Oil Co. Russell, Kansas.
(Address)

SUBSCRIBED AND SWORN to before me this 14 day of November, 1942
My Commission Expires Sept. 26, 1946
Notary Public.

My commission expires