

15-137-30062-00-00

STATE OF KANSAS
STATE CORPORATION COMMISSION


Form CP-4

WELL PLUGGING RECORD

Give All Information Completely
Make Required Affidavit
Mail or Deliver Report to:
Conservation Division
State Corporation Commission
211 No. Broadway
Wichita, Kansas

Norton County, Sec. 13 Twp. 5S Rge. 22 (W)

Location as "NE/CNW/SW" or footage from lines C NW NE
Lease Owner Abercrombie Drilling, Inc.
Lease Name Fitzhugh Well No. 1
Office Address 801 Union Center Wichita, Kansas
Character of Well (completed as Oil, Gas or Dry Hole) Dry Hole
Date well completed October 1 19 65
Application for plugging filed Verbally September 30 19 65
Application for plugging approved Verbally September 30 19 65
Plugging commenced October 1 19 65
Plugging completed October 1 19 65
Reason for abandonment of well or producing formation Dry

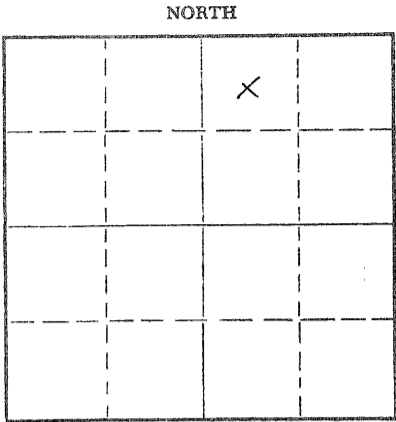

Locate well correctly on above Section Plat

If a producing well is abandoned, date of last production 19
Was permission obtained from the Conservation Division or its agents before plugging was commenced? Yes

Name of Conservation Agent who supervised plugging of this well W. L. Nichols Morland, Kansas
Producing formation _____ Depth to top _____ Bottom _____ Total Depth of Well 3565 Feet
Show depth and thickness of all water, oil and gas formations.

OIL, GAS OR WATER RECORDS

CASING RECORD

FORMATION	CONTENT	FROM	TO	SIZE	PUT IN	PULLED OUT
				8 5/8"	218'	None

Describe in detail the manner in which the well was plugged, indicating where the mud fluid was placed and the method or methods used in introducing it into the hole. If cement or other plugs were used, state the character of same and depth placed, from _____ feet to _____ feet for each plug set.

Filled hole w/ heavy mud to 540'.
Set 1st plug at 540' w/ 14 sacks cement, 1/2 sack hulls
Filled hole w/ heavy mud to 210'
Set 2nd plug at 210' w/ 19 sacks cement, 1/4 sack hulls
Filled hole w/ heavy mud to 40'
Set 3rd plug at 40' w/ 10 sacks cement
Put 2 sacks cement in rat hole

RECEIVED
STATE CORPORATION COMMISSION

OCT 8 1965

10-8-65

CONSERVATION DIVISION
Wichita, Kansas

(If additional description is necessary, use BACK of this sheet)

Name of Plugging Contractor Abercrombie Drilling, Inc.
Address 801 Union Center Wichita, Kansas

STATE OF Kansas, COUNTY OF Sedgwick, ss.
Jack K. Wharton (employee of owner) of the above-described well, being first duly sworn on oath, says: That I have knowledge of the facts, statements, and matters herein contained and the log of the above-described well as filed and that the same are true and correct. So help me God.

(Signature) Jack K. Wharton

(Address)

SUBSCRIBED AND SWORN TO before me this 7th day of October, 19 65

My commission expires 10-5-1968

Mildred Supton
Notary Public.