


Give All Information Completely  
Make Required Affidavit  
Mail or Deliver Report to:  
Conservation Division  
State Corporation Commission  
211 No. Broadway  
Wichita, Kansas

WELL PLUGGING RECORD

15-137-00231-00-00

NORTH

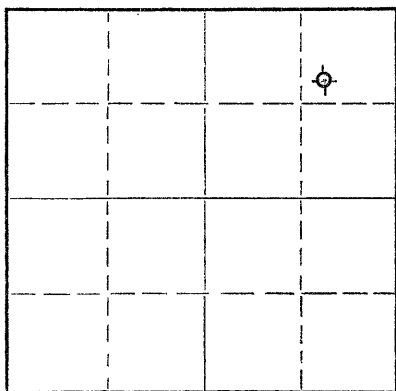

Locate well correctly on above  
Section Plat

Norton County, Sec. 12 Twp. 5 Rge. (E) 22 (W)  
Location as "NE/CNW/SW" or footage from lines SW NE NE  
Lease Owner D. G. Hansen & C-G Drilling Co.  
Lease Name Boyd Well No. 1  
Office Address 107 Rule Building, Wichita, Kansas  
Character of Well (completed as Oil, Gas or Dry Hole) Dry Hole  
Date well completed June 6 19 57  
Application for plugging filed June 6 19 57  
Application for plugging approved June 6 19 57  
Plugging commenced June 6 19 57  
Plugging completed June 6 19 57  
Reason for abandonment of well or producing formation too low structually

If a producing well is abandoned, date of last production 19  
Was permission obtained from the Conservation Division or its agents before plugging was commenced? Yes

Name of Conservation Agent who supervised plugging of this well  
Producing formation Depth to top Bottom Total Depth of Well 3560 Feet  
Show depth and thickness of all water, oil and gas formations.

OIL, GAS OR WATER RECORDS

CASING RECORD

| FORMATION | CONTENT | FROM | TO | SIZE   | PUT IN | PULLED OUT |
|-----------|---------|------|----|--------|--------|------------|
|           |         |      |    | 8-5/8" | 212'   | none       |
|           |         |      |    |        |        |            |
|           |         |      |    |        |        |            |
Describe in detail the manner in which the well was plugged, indicating where the mud fluid was placed and the method or methods used in introducing it into the hole. If cement or other plugs were used, state the character of same and depth placed, from feet to feet for each plug set.

Filled hole with heavy mud to 207'. Set plug. Put in 1/2 sack Hulls and 15 sacks of cement. Filled with heavy mud up to 40'. Set plug. Filled to top with 1/2 sack Hulls and 10 sacks cement.

(If additional description is necessary, use BACK of this sheet)

Name of Plugging Contractor C-G Drilling Co.  
Address 107 Rule Building, Wichita, Kansas

STATE OF KANSAS, COUNTY OF SEDGWICK, ss.  
Jay H. Galloway (employee of owner) or (owner or operator) of the above-described well, being first duly sworn on oath, says: That I have knowledge of the facts, statements, and matters herein contained and the log of the above-described well as filed and that the same are true and correct. So help me God.

(Signature) Jay H. Galloway  
107 Rule Bldg.  
(Address)

SUBSCRIBED AND SWORN TO before me this 10th day of June, 1957

My commission expires May 20, 1959

Vicky Jacobs  
Notary Public.  
STATE CORPORATION COMMISSION  
6-11-57

PLUGGING  
SEC 12 T 5 22W  
BOOK PAGE 19 LINE 11

CONSERVATION DIVISION  
Wichita, Kansas

JUN 11 1957