

15137-00184-00-00


STATE OF KANSAS  
STATE CORPORATION COMMISSION

Give All Information Completely  
Make Required Affidavit  
Mail or Deliver Report to:  
Conservation Division  
State Corporation Commission  
800 Bitting Building  
Wichita, Kansas

WELL PLUGGING RECORD

Norton County. Sec. 12 Twp. 5 Rge. (E) 22 (W)  
Location as "NE/CNW/SW" or footage from lines SW SW NW  
Lease Owner Jones, Shelburne & Farmer, Inc.  
Lease Name Weogard Well No. 1  
Office Address Russell, Kansas  
Character of Well (completed as Oil, Gas or Dry Hole) dry  
Date well completed 1-15 19 55  
Application for plugging filed 1-15 19 55  
Application for plugging approved 1-15 19 55  
Plugging commenced 1-15 19 55  
Plugging completed 1-15 19 55  
Reason for abandonment of well or producing formation dry

NORTH

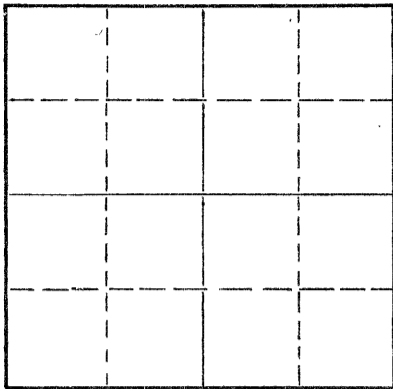

Locate well correctly on above  
Section Plat

If a producing well is abandoned, date of last production never produced 19  
Was permission obtained from the Conservation Division or its agents before plugging was commenced? yes

Name of Conservation Agent who supervised plugging of this well Eldon Petty  
Producing formation \_\_\_\_\_ Depth to top \_\_\_\_\_ Bottom \_\_\_\_\_ Total Depth of Well 3551 Feet  
Show depth and thickness of all water, oil and gas formations.

OIL, GAS OR WATER RECORDS

CASING RECORD

| FORMATION | CONTENT | FROM | TO | SIZE  | PUT IN | PULLED OUT |
|-----------|---------|------|----|-------|--------|------------|
|           |         |      |    | 8 5/8 | 166    | None       |
|           |         |      |    |       |        |            |
|           |         |      |    |       |        |            |
Describe in detail the manner in which the well was plugged, indicating where the mud fluid was placed and the method or methods used in introducing it into the hole. If cement or other plugs were used, state the character of same and depth placed, from \_\_\_\_\_ feet to \_\_\_\_\_ feet for each plug set.

1. Filled hole with heavy mud
2. Pushed plug to 166'
3. Dumped 1/2 sack hulls on top of plug
4. Mixed 15 sacks cement and dumped on top of hulls
5. Filled hole to top
6. Pushed plug to 40'
7. Dumped in 1/2 sack hulls
8. Mixed 10 sacks cement and filled hole to top with same

(If additional description is necessary, use BACK of this sheet)  
Name of Plugging Contractor Jones, Shelburne & Farmer, Inc. 1-28-55  
Address Russell, Kansas CONSERVATION DIVISION  
Wichita, Kansas

STATE OF Kansas, COUNTY OF Russell, ss.  
John O. Farmer (employee of owner) or (owner or operator) of the above-described well, being first duly sworn on oath, says: That I have knowledge of the facts, statements, and matters herein contained and the log of the above-described well as filed and that the same are true and correct. So help me God.  
(Signature) John O. Farmer  
Russell, Kansas (Address)

SUBSCRIBED AND SWORN TO before me this 15th day of January, 19 55  
Dennie Pratt Notary Public.

My commission expires July 14, 1958

PLUGGING  
FILE DEC 18 5 22W  
PAGE 91 LINE 30