


Give All Information Completely
Make Required Affidavit
Mail or Deliver Report to:
Conservation Division
State Corporation Commission
212 No. Market
Wichita, Kansas

WELL PLUGGING RECORD

NORTON County, Sec. 11 Twp. 5S Rge. 22 (E) (W)

Location as "NE/CNW/SW" or footage from lines NE SE SE
Lease Owner FOUR-WAY OPERATING, INC.
Lease Name STENGER Well No. 1
Office Address P O BOX 698, GREAT BEND, KANSAS 67530
Character of Well (completed as Oil, Gas or Dry Hole) DRY HOLE
Date well completed JUNE 23 19 70
Application for plugging filed JUNE 23 19 70
Application for plugging approved JUNE 23 19 70
Plugging commenced JUNE 23 19 70
Plugging completed JUNE 23 19 70
Reason for abandonment of well or producing formation TOO LOW STRUCTURALLY

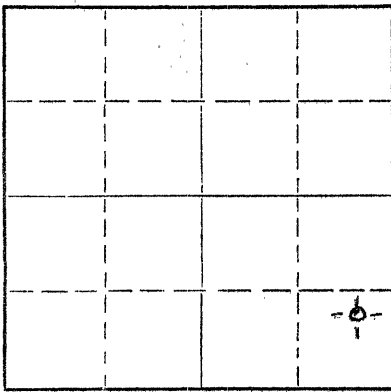

Locate well correctly on above Section Plat

If a producing well is abandoned, date of last production _____ 19 ____
Was permission obtained from the Conservation Division or its agents before plugging was commenced? YES

Name of Conservation Agent who supervised plugging of this well W L NICHOLS
Producing formation _____ Depth to top _____ Bottom _____ Total Depth of Well 3592 Feet
Show depth and thickness of all water, oil and gas formations.


OIL, GAS OR WATER RECORDS

CASING RECORD

FORMATION	CONTENT	FROM	TO	SIZE	PUT IN	PULLED OUT
				8 5/8"	211.57'	None

Describe in detail the manner in which the well was plugged, indicating where the mud fluid was placed and the method or methods used in introducing it into the hole. If cement or other plugs were used, state the character of same and depth placed, from _____ feet to _____ feet for each plug set.

FILLED WITH HEAVY MUD TO 940'. SET PLUG.
PUT IN 100 SACKS CEMENT, FILLED WITH NEW MUD TO 230'. SET PLUG. PUT IN 20 SACKS CEMENT. FILLED WITH HEAVY MUD TO 40'. SET PLUG. PUT IN 10 SACKS CEMENT & 1/2 SACK HULLS - FILLED TO TOP.

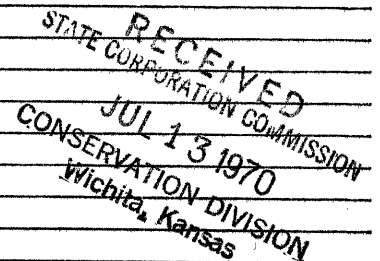

(If additional description is necessary, use BACK of this sheet)
Name of Plugging Contractor C-G DRILLING CO.
Address 1107 UNION NATIONAL BLDG., WICHITA, KANSAS 67202

STATE OF KANSAS, COUNTY OF SEDGWICK, ss.
Jay H. Galloway (employee of owner) or (owner or operator) of the above-described well, being first duly sworn on oath, says: That I have knowledge of the facts, statements, and matters herein contained and the log of the above-described well as filed and that the same are true and correct. So help me God.

(Signature) Jay H. Galloway
1107 Union Natl Bldg
(Address)

Subscribed and sworn to before me this 26th day of June, 19 70

My commission expires December 7, 1971

Phyllis Buchanan
Phyllis Buchanan
Notary Public.

