

15-137-20115-00-00


STATE OF KANSAS
STATE CORPORATION COMMISSION

WELL PLUGGING RECORD

Give All Information Completely
Make Required Affidavit
Mail or Deliver Report to
Conservation Division
State Corporation Comm.
245 North Water
Wichita, KS 67202

Norton County, Sec. 11 Twp. 5S Rge. 22W E/W
Location as "NE/CNW 1/4 SW 1/4" or footage from lines
N/2 SW/4

Lease Owner Abercrombie Drilling, Inc.
Lease Name STENGER "B" Well No. 2
Office Address 801 Union Center, Wichita, Kansas 67202
Character of Well (Completed as Oil, Gas or Dry Hole)
Dry Hole

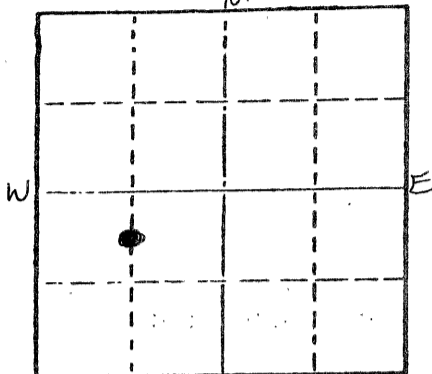

Date Well completed 2-26-1977
Application for plugging filed (Verbally) 2-26-1977
Application for plugging approved (Verbally) 2-26-1977
Plugging commenced 2-26-1977
Plugging completed 2-26-1977
Reason for abandonment of well or producing formation
No commercial quantity of oil or gas encountered
If a producing well is abandoned, date of last production 19

Was permission obtained from the Conservation Division or its agents before plugging was commenced? Yes

Name of Conservation Agent who supervised plugging of this well Gilbert Balthazor
Producing formation _____ Depth to top _____ Bottom _____ Total Depth of Well _____
Show depth and thickness of all water, oil and gas formations.

OIL, GAS OR WATER RECORDS

CASING RECORD

FORMATION	CONTENT	FROM	TO	SIZE	PUT IN	PULLED OUT

Describe in detail the manner in which the well was plugged, indicating where the mud fluid was placed and the method or methods used in introducing it into the hold. If cement or other plugs were used, state the character of same and depth placed, from _____ feet to _____ feet for each plug set.

T.D. 3517'
Set 1st plug at 950' with 70 sx.,
2nd plug at 250' with 20 sx.,
3rd plug, 40' solid bride with 10 sx.

RECEIVED
STATE CORPORATION COMMISSION

MAR 07 1977

Plug was down at 1:00 p.m. 2-26-77.
State Plugger - Gilbert Balthazor.

CONSERVATION DIVISION
Wichita, Kansas

3-2-77

(If additional description is necessary, use BACK of this sheet)

Name of Plugging Contractor Abercrombie Drilling, Inc.

STATE OF Kansas COUNTY OF Sedgwick ss:

Jack L. Partridge, Asst. Sec.-Treas. (employee of owner) or (owner or operator) of the above-described well, being first duly sworn on oath, says: That I have knowledge of the facts, statements, and matters herein contained and the log of the above-described well as filed and that the same are true and correct. So help me God.

(Signature) *Jack L. Partridge*

801 Union Center, Wichita, Kansas 67202
(Address)

SUBSCRIBED AND SWORN TO before me this 3rd day of March, 1977

My commission expires _____

Kathy S. Goertz
Kathy S. Goertz Notary Public.

