

15-137-20031-00-20


STATE OF KANSAS  
STATE CORPORATION COMMISSION

Form CP-4

Give All Information Completely  
Make Required Affidavit  
Mail or Deliver Report to:  
Conservation Division  
State Corporation Commission  
212 No. Market  
Wichita, Kansas 67202

WELL PLUGGING RECORD

NORTH

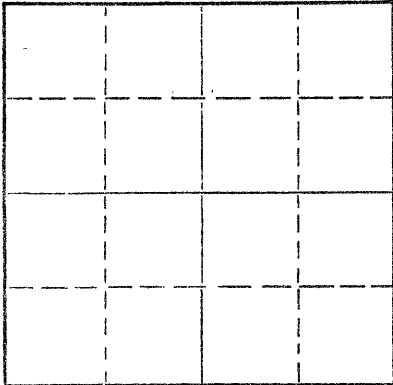

Locate well correctly on above  
Section Plat

Norton County. Sec. 9 Twp. 5 Rge 22 (E) (W)  
Location as "NE/CNW/SE" or footage from lines SW NE SE  
Lease Owner Okmar Oil Company  
Lease Name Voss #1 Well No.  
Office Address Box 723, Hays, Kansas 67601  
Character of Well (completed as Oil, Gas or Dry Hole)  
Date well completed 19  
Application for plugging filed 19  
Application for plugging approved 19  
Plugging commenced 10/29/71 19  
Plugging completed 10/31/71 19  
Reason for abandonment of well or producing formation depleted.  
If a producing well is abandoned, date of last production 19  
Was permission obtained from the Conservation Division or its agents before plugging was commenced? yes

Name of Conservation Agent who supervised plugging of this well Nicholas  
Producing formation Depth to top Bottom Total Depth of Well 3566 Feet  
Show depth and thickness of all water, oil and gas formations.

OIL, GAS OR WATER RECORDS

CASING RECORD

FORMATION	CONTENT	FROM	TO	SIZE	PUT IN	PULLED OUT
		STATE CORPORATION COMMISSION		8-5/8	263	none
		CONSERVATION DIVISION		5 1/2"	3563	1012'
		Wichita, Kansas				

3-7-72

Describe in detail the manner in which the well was plugged, indicating where the mud fluid was placed and the method or methods used in introducing it into the hole. If cement or other plugs were used, state the character of same and depth placed, from feet to feet for each plug set.

Sanded hole to 3550' and ran 5 sacks of cement. Shot pipe at 1507', 1311', 1117', 1020', pulled pipe. Pumped 5 sacks hulls, 17 sacks gel, 100 sacks cement, 9 sacks gel and 25 sacks cement, 4 sacks gel and 10 sacks cement.

PLUGGING COMPLETE.

(If additional description is necessary, use BACK of this sheet)  
Name of Plugging Contractor KNIGHT CASING PULLING CO., INC.  
Address CHASE, KANSAS

STATE OF KANSAS, COUNTY OF RICE, ss.  
NOEL J. KNIGHT (employee of owner) or (owner or operator) of the above-described well, being first duly sworn on oath, says: That I have knowledge of the facts, statements, and matters herein contained and the log of the above-described well as filed and that the same are true and correct. So help me God.

(Signature) Noel Knight  
CHASE, KANSAS  
(Address)

SUBSCRIBED AND SWORN TO before me this 31st day of October, 1971  
MARGARET MELCHER  
NOTARY PUBLIC  
Rice County, Kansas  
My Commission Expires Feb. 15, 1975

Margaret Melcher  
Notary Public.