

**CARD MUST BE SIGNED**

API Number 15- 137-20, 355-00-00

NE NE SW Sec 27 Twp 5 S, Rge 23W ☐ East  
(location) ☒ West

2310  
..... Ft North from Southeast Corner of Section  
2970  
..... Ft West from Southeast Corner of Section  
(Note: Locate well on Section Plat on reverse side)

Nearest lease or unit boundary line ..... 2310 ..... feet.  
County ..... Norton .....  
Lease Name ..... Krauss "A" ..... Well# ..... 1 .....  
Domestic well within 330 feet :    ☐ yes    ☒ no  
Municipal well within one mile :    ☐ yes    ☒ no

Depth to Bottom of fresh water ..... 120 ..... feet  
 Lowest usable water formation ..... Dakota .....  
 Depth to Bottom of usable water ..... 1300 ..... feet  
 Surface pipe by Alternate :    1 ☐    2 ☒ .....  
 Surface pipe to be set ..... 325 ..... feet  
 Conductor pipe if any required ..... --- ..... feet  
 Ground surface elevation ..... --- ..... feet MSL  
 This Authorization Expires ..... 8-28-85 .....  
 Approved By ..... 3-28-85 .....

Operator .....	-----
Well Name .....	
Comp Date .....	
Projected Total Depth .....	3950 feet
Projected Formation at TD .....	Arbuckle
Expected Producing Formations .....	Lans/KC

Date ..... Signature of Operator or Agent  Title ..... VICE-PRESIDENT

Form C-1 4/84

Must be filed with the K.C.C. five (5) days prior to commencing well  
This card void if drilling not started within six (6) months of date received by K.C.C.

CONSERVATION DIVISION  
Wichita, Kansas


FEB 28 1985

2-28-85

### Important procedures to follow:

1. Notify District office before setting surface casing.
2. Set surface casing by circulating cement to the top.
3. File completion forms ACO-1 with K.C.C. within 90 days of well completion, following instructions on ACO-1, side 1, and including copies of wireline logs.
4. Notify District office 48 hours prior to old well workover or re-entry.
5. Prior to plugging, prepare a plugging plan, then obtain agreement from the appropriate district office for an approved plugging plan.
6. Submit plugging report (CP-4) to K.C.C. after plugging is completed.
7. Obtain an approved injection docket number before disposing of salt water.
8. Notify K.C.C. within 10 days when injection commences or terminates.
9. If an alternate 2 completion, cement in the production pipe from below any usable water to surface within 120 days of spud date.

RECEIVED  
STATE CORPORATION COMMISSION  
1 MILE  
Non-regular Section of Land

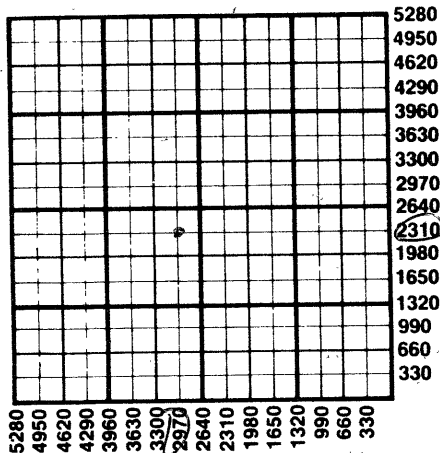

State Corporation Commission of Kansas  
Conservation Division  
200 Colorado Derby Building  
Wichita, Kansas 67202  
(316) 263-3238