

15-039-00154-00-00


STATE OF KANSAS  
STATE CORPORATION COMMISSION

WELL PLUGGING RECORD

Give All Information Completely  
Make Required Affidavit  
Mail or Deliver Report to:  
Conservation Division  
State Corporation Commission  
800 Bittling Building  
Wichita, Kansas

Decatur County, Sec. 1 Twp. 5S Rge. 27W (NW/4) (W)

Location as "NE/CNW/SW" or footage from lines NW/4 NW/4 SW/4  
Lease Owner R. W. Shields  
Lease Name Carter Well No. 1  
Office Address 409 First Natl Bank Bldg., Wichita, Kansas  
Character of Well (completed as Oil, Gas or Dry Hole) Dry Hole  
Date well completed March 29, 1956  
Application for plugging filed March 29, 1956  
Application for plugging approved March 29, 1956  
Plugging commenced March 29, 1956  
Plugging completed March 29, 1956  
Reason for abandonment of well or producing formation Dry Hole

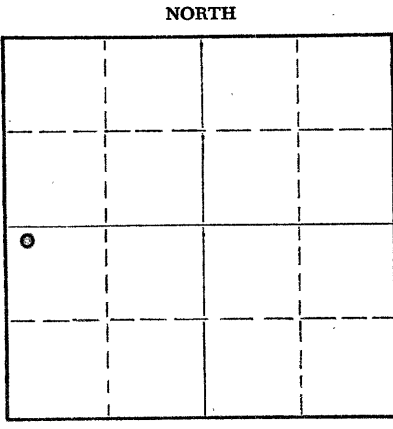

Locate well correctly on above Section Plat

If a producing well is abandoned, date of last production 19  
Was permission obtained from the Conservation Division or its agents before plugging was commenced? yes

Name of Conservation Agent who supervised plugging of this well Eldon Petty  
Producing formation Depth to top Bottom Total Depth of Well 3810 Feet  
Show depth and thickness of all water, oil and gas formations.

OIL, GAS OR WATER RECORDS

CASING RECORD

FORMATION	CONTENT	FROM	TO	SIZE	PUT IN	PULLED OUT

Describe in detail the manner in which the well was plugged, indicating where the mud fluid was placed and the method or methods used in introducing it into the hole. If cement or other plugs were used, state the character of same and depth placed, from feet to feet for each plug set.

Filled hole with heavy mud from 3810 feet to 240 feet. Set plug at 240 feet. Dumped 1/2 sack of hulls and 15 sacks of cement on plug and completed filling hole with heavy mud to 40 feet. Set second plug at 40 feet. Dumped 1/2 sack of hulls and 10 sacks of cement on plug to fill to bottom of cellar.

RECEIVED  
APR 4 1956  
CONSERVATION DIVISION  
WICHITA, KANSAS

4-4-56

(If additional description is necessary, use BACK of this sheet)  
Name of Plugging Contractor Barnett Drilling, Inc.  
Address 409 First National Bank Bldg., Wichita 2, Kansas

STATE OF Kansas COUNTY OF Sedgwick, ss. contractor  
F. R. Stubblefield (employee of owner) or (owner or operator) of the above-described well, being first duly sworn on oath, says: That I have knowledge of the facts, statements, and matters herein contained and the log of the above-described well as filed and that the same are true and correct. So help me God.

(Signature) F. R. Stubblefield  
409 First National Bank Bldg., Wichita 2, Kansas  
(Address)

SUBSCRIBED AND SWORN TO before me this 3rd day of April, 1956

Mildred F. Willis  
Notary Public.

My commission expires February 27, 1960

PLUGGING  
FILE SEC 1 T 5 R 27W  
BOOK PAGE 50 LINE 38