


Give All Information Completely  
Make Required Affidavit  
Mail or Deliver Report to:  
Conservation Division  
State Corporation Commission  
212 No. Market  
Wichita, Kansas

WELL PLUGGING RECORD

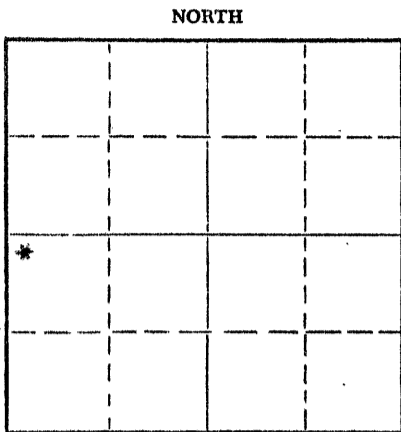

Locate well correctly on above Section Plat

Norton County. Sec. 35 Twp. 5S Rge. 25W (~~Box~~) (W)  
Location as "NE/CNW%SW%" or footage from lines NW NW SW  
Lease Owner Francis Weigel  
Lease Name Spieß Well No. 1  
Office Address Gorham, Kansas  
Character of Well (completed as Oil, Gas or Dry Hole) Oil  
Date well completed \_\_\_\_\_ 19\_\_\_\_  
Application for plugging filed March 10, 1966  
Application for plugging approved March 10, 1966  
Plugging commenced March 11, 1966  
Plugging completed March 11, 1966  
Reason for abandonment of well or producing formation \_\_\_\_\_

If a producing well is abandoned, date of last production \_\_\_\_\_ 19\_\_\_\_  
Was permission obtained from the Conservation Division or its agents before plugging was commenced? yes

Name of Conservation Agent who supervised plugging of this well W. L. Nichols  
Producing formation \_\_\_\_\_ Depth to top \_\_\_\_\_ Bottom \_\_\_\_\_ Total Depth of Well 4055 Feet  
Show depth and thickness of all water, oil and gas formations.

OIL, GAS OR WATER RECORDS				CASING RECORD		
FORMATION	CONTENT	FROM	TO	SIZE	PUT IN	PULLED OUT
				8 5/8"	245'	
				4 1/2"	3727'	

Describe in detail the manner in which the well was plugged, indicating where the mud fluid was placed and the method or methods used in introducing it into the hole. If cement or other plugs were used, state the character of same and depth placed, from \_\_\_\_\_ feet to \_\_\_\_\_ feet for each plug set.

245' - 8 5/8" Surface pipe, cement circulated with 150 sacks.  
3727' - 4 1/2" Production casing cemented with 120 sacks.  
Open hole completion  
Pushed plug to 3700' and set 5 sacks cement with dump bailer.  
Pull 4 1/2" casing. Ran bailer and found top of fluid @ 300'.  
Set wood and rock bridge @ 300' and filled hole to bottom of  
cellar using 5 yards Redi-Mix cement.

RECEIVED  
STATE CORPORATION COMMISSION  
MAR 21 1967  
03-21-1967  
CONSERVATION DIVISION  
WICHITA, KANSAS

(If additional description is necessary, use BACK of this sheet)  
Name of Plugging Contractor Glenn & Smith Pipe Pulling Company  
Address 204 E. 6th Ellinwood, Kansas

STATE OF \_\_\_\_\_, COUNTY OF \_\_\_\_\_, ss. \_\_\_\_\_ (employee of owner) or (owner or operator) of the above-described well, being first duly sworn on oath, says: That I have knowledge of the facts, statements, and matters herein contained and the log of the above-described well as filed and that the same are true and correct. So help me God.

(Signature) [Signature]

(Address) \_\_\_\_\_  
March 20th day of March 1967  
Carlena Jones  
Notary Public.

My commission expires 12-1-69