


Give All Information Completely
Make Required Affidavit
Mail or Deliver Report to:
Conservation Division
State Corporation Commission
212 No. Market
Wichita, Kansas

WELL PLUGGING RECORD

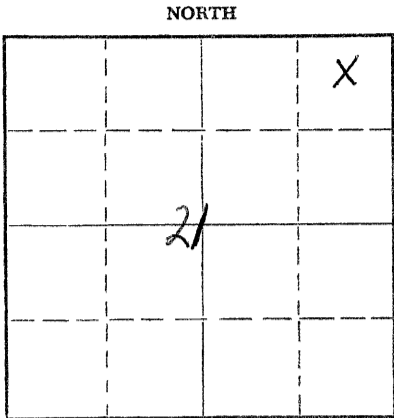

Locate well correctly on above Section Plat

Norton County, Sec. 21 Twp. 5S Rge. 16E/25 (W)

Location as "NE/CNW/SW" or footage from lines C NE NE
Lease Owner Abercrombie Drilling, Inc.
Lease Name Otter Well No. 1
Office Address 801 Union Center, Wichita, Kansas
Character of Well (completed as Oil, Gas or Dry Hole) Dry Hole
Date well completed 10-21 19 66
Application for plugging filed (Verbally) October 21, 19 66
Application for plugging approved (Verbally) October 21, 19 66
Plugging commenced October 21, 19 66
Plugging completed October 21, 19 66
Reason for abandonment of well or producing formation Dry Hole

If a producing well is abandoned, date of last production _____ 19____
Was permission obtained from the Conservation Division or its agents before plugging was commenced? Yes

Name of Conservation Agent who supervised plugging of this well W. H. Nichols, Moreland, Kansas
Producing formation _____ Depth to top _____ Bottom _____ Total Depth of Well 4040 Feet
Show depth and thickness of all water, oil and gas formations.

OIL, GAS OR WATER RECORDS

CASING RECORD
RECEIVED
OCT 27 1966
10-27-1966
CONSERVATION DIVISION
WICHITA, KANSAS

FORMATION	CONTENT	FROM	TO	SIZE	PUT IN	PULLED OUT
				7"	255'	

Describe in detail the manner in which the well was plugged, indicating where the mud fluid was placed and the method or methods used in introducing it into the hole. If cement or other plugs were used, state the character of same and depth placed, from _____ feet to _____ feet for each plug set.

1st plug at 600 feet with 15 sacks of cement; 2nd plug at 240 feet with 1/2 sack of hulls and 15 sacks of cement; 3rd plug at 40 feet with 1/2 sack of hulls and 10 sacks of cement; 2 sacks of cement in rat hole.

(If additional description is necessary, use BACK of this sheet)

Name of Plugging Contractor Abercrombie Drilling, Inc.
Address 801 Union Center, Wichita, Kansas

STATE OF KANSAS, COUNTY OF SEDGWICK, ss.
Jack K. Wharton (employee of owner) or (operator) of the above-described well, being first duly sworn on oath, says: That I have knowledge of the facts, statements, and matters herein contained and the log of the above-described well as filed and that the same are true and correct. So help me God.

(Signature) Jack K. Wharton
801 Union Center, Wichita, Kansas
(Address)

SUBSCRIBED AND SWORN to before me this 24th day of October, 19 66
Margo Dee Montgomery
Margo Dee Montgomery
Notary Public.

My commission expires March 31, 1970