

15-137-20063-00-00


STATE OF KANSAS  
STATE CORPORATION COMMISSION

Form CP-4

WELL PLUGGING RECORD

Give All Information Completely  
Make Required Affidavit  
Mail or Deliver Report to:  
Conservation Division  
State Corporation Commission  
212 No. Market  
Wichita, Kansas 67202

NORTH

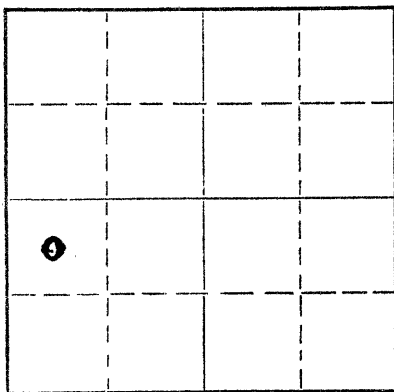

Locate well correctly on above  
Section Plat

Norton County. Sec. 14 Twp. 5 Rge. 25 (E) W (W)

Location as "NE/CNW/SW" or footage from lines C NW SW

Lease Owner National Associated Petroleum Co.

Lease Name Agnes Mindrup Well No. 1

Office Address 4th Floor, Petroleum Building, Tulsa, Oklahoma

Character of Well (completed as Oil, Gas or Dry Hole) Dry Hole

Date well completed 11-10 19 70

Application for plugging filed 11-10 19 70

Application for plugging approved 11-10 19 70

Plugging commenced 11-10 19 70

Plugging completed 11-10 19 70

Reason for abandonment of well or producing formation Dry Hole

If a producing well is abandoned, date of last production \_\_\_\_\_ 19 \_\_\_\_\_

Was permission obtained from the Conservation Division or its agents before plugging was commenced? Yes

Name of Conservation Agent who supervised plugging of this well Bill Nichols

Producing formation \_\_\_\_\_ Depth to top \_\_\_\_\_ Bottom \_\_\_\_\_ Total Depth of Well \_\_\_\_\_ Feet

Show depth and thickness of all water, oil and gas formations.


OIL, GAS OR WATER RECORDS

CASING RECORD

FORMATION	CONTENT	FROM	TO	SIZE	PUT IN	PULLED OUT
<u>Surface Pipe</u>				<u>8 5/8"</u>	<u>243'</u>	

Describe in detail the manner in which the well was plugged, indicating where the mud fluid was placed and the method or methods used in introducing it into the hole. If cement or other plugs were used, state the character of same and depth placed, from \_\_\_\_\_ feet to \_\_\_\_\_ feet for each plug set.

- 1st Plug set at 1250' with 100 cu. ft.
- 2nd Plug set at 260' with 25 cu. ft.
- 3rd Plug set at 40' with 10 cu. ft.

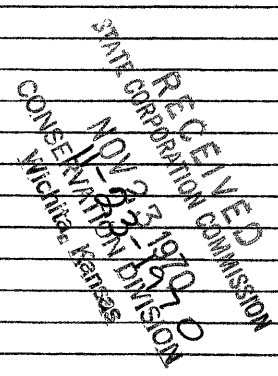

(If additional description is necessary, use BACK of this sheet)

Name of Plugging Contractor L. J. Dreiling & Sons, Inc.


Address R.R. #2, Victoria, Kansas 67671

STATE OF Kansas, COUNTY OF Ellis, ss. I, Leo F. Dreiling

(employee of owner) or (~~owner~~) of the above-described well, being first duly sworn on oath, says: That I have knowledge of the facts, statements, and matters herein contained and the log of the above-described well as filed and that the same are true and correct. So help me God.

(Signature) Leo F. Dreiling  
Leo F. Dreiling, Victoria, Kansas 67671

13th day of November, 19 70

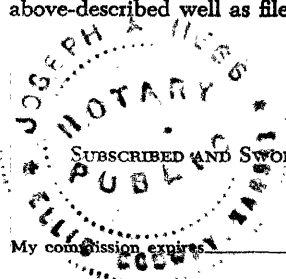

Joseph A. Hess  
Joseph A. Hess Notary Public.