

15-039-20023-00-00

STATE OF KANSAS
STATE CORPORATION COMMISSION


Form CP-4

WELL PLUGGING RECORD

Give All Information Completely
Make Required Affidavit
Mail or Deliver Report to:
Conservation Division
State Corporation Commission
212 No. Market
Wichita, Kansas

Decatur County, Sec. 15 Twp. 5S Rge. (E) 27 (W)

Location as "NE/CNW/SW" or footage from lines NE NW NE
Lease Owner Abercrombie Drilling, Inc.
Lease Name BOLAND Well No. 1
Office Address 801 Union Center
Character of Well (completed as Oil, Gas or Dry Hole) Dry Hole
Date well completed September 2, 19 67
Application for plugging filed (Verbally) September 1, 19 67
Application for plugging approved (Verbally) September 1, 19 67
Plugging commenced September 2, 19 67
Plugging completed September 2, 19 67
Reason for abandonment of well or producing formation Dry Hole

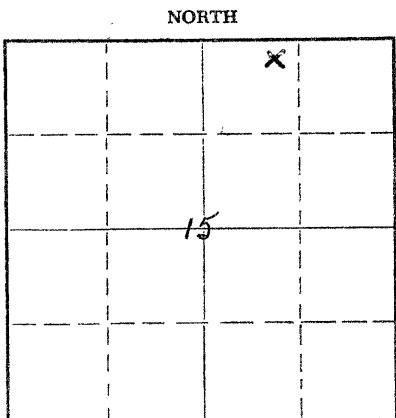

Locate well correctly on above Section Plat

If a producing well is abandoned, date of last production 19
Was permission obtained from the Conservation Division or its agents before plugging was commenced? Yes

Name of Conservation Agent who supervised plugging of this well Leo Massey
Producing formation _____ Depth to top _____ Bottom _____ Total Depth of Well 3824 Feet
Show depth and thickness of all water, oil and gas formations.

OIL, GAS OR WATER RECORDS

CASING RECORD

FORMATION	CONTENT	FROM	TO	SIZE	PUT IN	PULLED OUT
				7"	252'	None

Describe in detail the manner in which the well was plugged, indicating where the mud fluid was placed and the method or methods used in introducing it into the hole. If cement or other plugs were used, state the character of same and depth placed, from _____ feet to _____ feet for each plug set.

1st plug set at 1500' back to 1200' with 65 sx. cement; 2nd plug back to 240' with 40 sx. cement; heavy mud to 40'; top plugged with 5 sx. cement and 1/2 sx. hulls. Plugged with pump truck. Cement circulated and job was completed at 6:00 a.m., September 2, 1967.

RECEIVED
STATE CORPORATION COMMISSION
SEP 12 1967

CONSERVATION DIVISION
WICHITA, KANSAS

(If additional description is necessary, use BACK of this sheet)

Name of Plugging Contractor Abercrombie Drilling, Inc.
Address West Tenth Street, Great Bend, Kansas

9-12-67

STATE OF KANSAS, COUNTY OF SEDGWICK, ss.
Jack K. Wharton (employee of owner) or (~~owner~~ ~~operator~~) of the above-described well, being first duly sworn on oath, says: That I have knowledge of the facts, statements, and matters herein contained and the log of the above-described well as filed and that the same are true and correct. So help me God.

(Signature) Jack K. Wharton
Jack K. Wharton
801 Union Center; Wichita, Kansas
(Address)

SUBSCRIBED AND SWORN TO before me this 8th day of September, 19 67

My commission expires March 31, 1970

Margo Dee Montgomery
Margo Dee Montgomery Notary Public.