


STATE OF KANSAS
STATE CORPORATION COMMISSION

Give All Information Completely
Make Required Affidavit
Mail or Deliver Report to:
Conservation Division
State Corporation Commission
212 North Market, Insurance Bldg.
Wichita, Kansas

15-039-00140-00-00
WELL PLUGGING RECORD

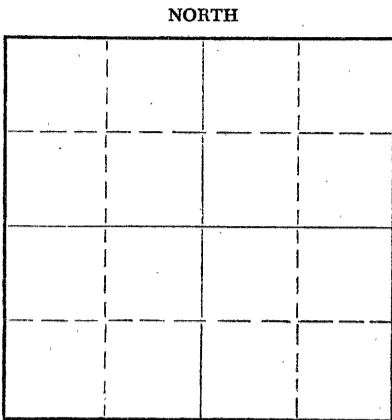

Locate well correctly on above
Section Plat

Decatur County, Sec. 15 Twp. 5 Rge. 27 (E) W(W)
Location as "NE/CNW/SW" or footage from lines C NE NE
Lease Owner Burch Drilling Co., Inc.
Lease Name Boland #1 Well No. _____
Office Address Wichita, Kansas
Character of Well (completed as Oil, Gas or Dry Hole) _____
Date well completed _____ 19____
Application for plugging filed _____ 19____
Application for plugging approved _____ 19____
Plugging commenced 1-3-60 _____ 19____
Plugging completed 1-8-60 _____ 19____
Reason for abandonment of well or producing formation _____

If a producing well is abandoned, date of last production _____ 19____
Was permission obtained from the Conservation Division or its agents before plugging was commenced? yes

Name of Conservation Agent who supervised plugging of this well A.D. Fabricius
Producing formation _____ Depth to top _____ Bottom _____ Total Depth of Well 3850' Feet
Show depth and thickness of all water, oil and gas formations.

OIL, GAS OR WATER RECORDS

CASING RECORD

FORMATION	CONTENT	FROM	TO	SIZE	PUT IN	PULLED OUT
				8-5/8"	210'	none
				4-1/2"	3849'	1229'

Describe in detail the manner in which the well was plugged, indicating where the mud fluid was placed and the method or methods used in introducing it into the hole. If cement or other plugs were used, state the character of same and depth placed, from _____ feet to _____ feet for each plug set.

Checked the hole to 3827' and found it open.
Filled w/sand to 3725' and dumped 3 sacks of cement with bailer. Pulled 4 1/2" casing.
Cleared hoel and mudded the hole to 200', set rock bridge to 190' and dumped 25 sacks of cement. Mudded the hole to 40', set rock bridge to 30' and ran 10 sacks of cement to base of cellar.

RECEIVED
STATE CORPORATION COMMISSION

JAN 28 1960

PLUGGING COMPLETED

CONSERVATION DIVISION
Wichita, Kansas

(If additional description is necessary, use BACK of this sheet)
Name of Plugging Contractor Knight Casing Pulling Co.
Address Chase, Kansas

STATE OF KANSAS COUNTY OF RICE, ss.
I, Noel J. Knight (employee of owner) or (~~owner or operator~~) of the above-described

well, being first duly sworn on oath, says: That I have knowledge of the facts, statements, and matters herein contained and the log of the above-described well as filed and that the same are true and correct. So help me God.

(Signature) Noel J. Knight
Chase, Kansas (Address)

SUBSCRIBED AND SWORN TO before me this 26th day of January, 1960

My commission expires 9-27-62

Thomas V. Szyg
Notary Public.

WELL LOG BUREAU—KANSAS GEOLOGICAL SOCIETY

508 East Murdock, Wichita, Kansas

15-039-00 140-00-00


COPY

Company- BURCH DRILLING CO., INC.
Farm- Boland No. 1

SEC. 15 T. 5 R. 27W
C NE NE

Total Depth. 3880'
Comm. 11-20-59 Comp. 11-30-59
Shot or Treated.
Contractor.
Issued. 1-23-60

County Decatur
KANSAS

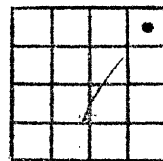

Elevation. 2670'

Production. Dry

CASING:

8 5/8" 215' cem w/160 sx.
4 1/2" 3879' cem w/125 sx.

Figures Indicate Bottom of Formations.

shale	245
shale & shells	1190
Anhydrite	1587
shale	1840
shale & lime	2250
Anhydrite	2285
shale & lime	2440
lime	3620
lime	3880 RTD
Total Depth	

TOPS:

Anhydrite	2252
Heebner	3628
Toronto	3652
Lansing	3670
Base Kansas City	3860

DST #1 3640-3720', op 1 hr., rec. 130'
muddy water w/a few specks oil. IBHP
890#/30 min., IFP 65#, FFP 95#, FBHP 760#.

DST #2 3720-3840', op 1 hr., rec. 200'
slightly oil cut watery mud, plus 1030'
oil cut salt water. IBHP 1190#/30 min.
IFP 180#, FFP 575#, FBHP 1140#/30 min.

DST #3 3734-3774' Failed

DST #4 3730-3756' Failed

DST #5 3743-3754' Failed

DST #6 3735-3756' Failed