

15-039-00905-00-00


STATE OF KANSAS
STATE CORPORATION COMMISSION

Give All Information Completely
Make Required Affidavit
Mail or Deliver Report to:
Conservation Division
State Corporation Commission
800 Biting Building
Wichita, Kansas

WELL PLUGGING RECORD

Decatur County, Sec. 23 Twp. 5S Rge. 1 (E) 27 (W)
C NL NW 1/4 SW 1/4

Location as "NE/CNW/SW" or footage from lines _____
Lease Owner R. W. Shields
Lease Name Cora Comfort Well No. 1
Office Address 308 Rule Building, Wichita 2, Kansas
Character of Well (completed as Oil, Gas or Dry Hole) Dry Hole
Date well completed November 13, 1954
Application for plugging filed November 13, 1954
Application for plugging approved November 13, 1954
Plugging commenced November 13, 1954
Plugging completed November 13, 1954
Reason for abandonment of well or producing formation Dry Hole

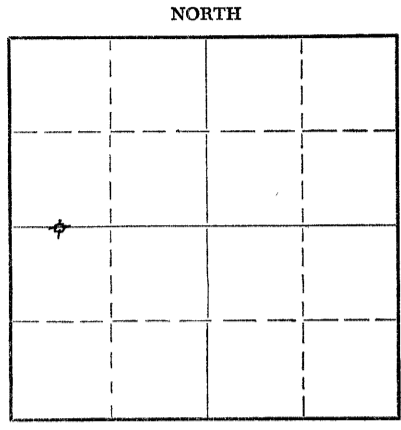

Locate well correctly on above Section Plat

If a producing well is abandoned, date of last production _____ 19____
Was permission obtained from the Conservation Division or its agents before plugging was commenced? Yes

Name of Conservation Agent who supervised plugging of this well Eldon Petty
Producing formation _____ Depth to top _____ Bottom _____ Total Depth of Well 3865 Feet
Show depth and thickness of all water, oil and gas formations.

OIL, GAS OR WATER RECORDS CASING RECORD

FORMATION	CONTENT	FROM	TO	SIZE	PUT IN	PULLED OUT
		0	214	8-5/8"	214'	- 0 -

Describe in detail the manner in which the well was plugged, indicating where the mud fluid was placed and the method or methods used in introducing it into the hole. If cement or other plugs were used, state the character of same and depth placed, from _____ feet to _____ feet for each plug set.

Filled hole with heavy mud from 3860 feet to 210 feet. Set Halliburton wooden plug at 210 feet. Dumped 1/2 sack hulls and 15 sacks cement on plug and completed filling hole with heavy mud to 40 feet. Set second wooden plug at forty feet; dumped 1/2 sack hulls and 10 sacks of cement on plug to fill to bottom of cellar.

(If additional description is necessary, use BACK of this sheet)
Name of Plugging Contractor Barnett Drilling, Inc. 11-16-54
Address 409 First National Bank Building, Wichita 2, Kansas

STATE OF Kansas, COUNTY OF Sedgwick, ss.
F. R. Stubblefield (employee of ~~owner~~ contractor) or (owner or operator) of the above-described well, being first duly sworn on oath, says: That I have knowledge of the facts, statements, and matters herein contained and the log of the above-described well as filed and that the same are true and correct. So help me God.

(Signature) F. R. Stubblefield
409 First National Bank Bldg, Wichita 2, Kans.
(Address)

SUBSCRIBED AND SWORN TO before me this 15th day of November, 19 54

My commission expires February 27, 1956 Mildred F. Willis Notary Public.

