


15-039-00403-06-00

STATE OF KANSAS
STATE CORPORATION COMMISSION

Give All Information Completely
Make Required Affidavit
Mail or Deliver Report to:
Conservation Division
State Corporation Commission
211 No. Broadway
Wichita, Kansas

WELL PLUGGING RECORD

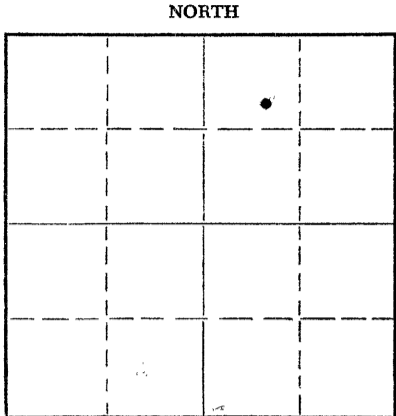

Locate well correctly on above
Section Plat

Decatur County. Sec. 22 Twp. 5S Rge. (E) 27 (W)
Location as "NE/CNW/SW" or footage from lines SE NW NE
Lease Owner Continental Oil Company
Lease Name J. E. Hardesty Well No. 2
Office Address Drawer 98 Plainville, Kansas
Character of Well (completed as Oil, Gas or Dry Hole) Oil
Date well completed June 17, 1952
Application for plugging filed August 22, 1956
Application for plugging approved September 19, 1956
Plugging commenced September 28, 1956
Plugging completed October 5, 1956
Reason for abandonment of well or producing formation Production depleted and other zones tested was non productive.
If a producing well is abandoned, date of last production March, 1955
Was permission obtained from the Conservation Division or its agents before plugging was commenced? Yes

Name of Conservation Agent who supervised plugging of this well Mr. Elden Petty
Producing formation Lansing KC Depth to top 3672 Bottom 3682 Total Depth of Well 3730 Feet
Show depth and thickness of all water, oil and gas formations. PB 3690

OIL, GAS OR WATER RECORDS

CASING RECORD

FORMATION	CONTENT	FROM	TO	SIZE	PUT IN	PULLED OUT
Lansing KC	Oil & Water	3,672	3,682	10 3/4	240	None
				5 1/2	3,755	1,504

Describe in detail the manner in which the well was plugged, indicating where the mud fluid was placed and the method or methods used in introducing it into the hole. If cement or other plugs were used, state the character of same and depth placed, from _____ feet to _____ feet for each plug set.

Set bridge plug at 3,650 feet and cemented with 4 sacks of cement.
Fill hole with mud to 240 feet and set plug with 25 sacks of cement.
Filled hole with mud to 20 feet and set plug with 10 sacks of cement to surface.

(If additional description is necessary, use BACK of this sheet)

Name of Plugging Contractor West Supply Company
Address Chase, Kansas

STATE OF Kansas, COUNTY OF Rooks, ss.
L. E. Powell (employee of owner) or (owner or operator) of the above-described well, being first duly sworn on oath, says: That I have knowledge of the facts, statements, and matters herein contained and the log of the above-described well as filed and that the same are true and correct. So help me God.

(Signature) L. E. Powell
Drawer 98, Plainville, Kansas
(Address)

SUBSCRIBED AND SWORN TO before me this 15 day of October, 1956

My commission expires December 2, 1957

[Signature] Notary Public.
STATE CORPORATION COMMISSION

RGW
10-15-56
State Corp. Comm.
RFD
File

PLUGGING
FILE SEC. 22 T. 5S R. 27W
BOOK PAGE 91 LINE 32

OCT 17 1956
CONSERVATION DIVISION
Wichita, Kansas
10-17-56