

CARD MUST BE TYPED

State of Kansas
NOTICE OF INTENTION TO DRILL
(see rules on reverse side)

CARD MUST BE SIGNED

Starting Date: 7-18-85
month day year

OPERATOR: License # 9123
Name Diamond Shamrock Exploration Company
Address P.O. Box 400
City/State/Zip Amarillo, Texas 79188
Contact Person Todd Lovett
Phone 806-378-3848

CONTRACTOR: License #
Name Not available
City/State

Well Drilled For:	Well Class:	Type Equipment:
☒ Oil	☐ Swd	☒ Mud Rotary
☐ Gas	☐ Inj	☐ Air Rotary
☐ OWWO	☐ Expl	☐ Cable
	☐ Wildcat	

If OWWO: old well info as follows:

Operator
Well Name
Comp Date Old Total Depth
Projected Total Depth 3900 feet
Projected Formation at TD
Expected Producing Formations Lansing-Kansas City

I certify that we will comply with K.S.A. 55-101, et seq., plus eventually plugging hole to K.C.C. specifications.

Date 6-28-85 Signature of Operator or Agent

API Number 15- 039-10,769-00-00
NW.. SE.. SE. Sec 10.. Twp 5S.. S, Rge 27..
(location)

..... 990..... Ft North from Southeast Corner of Section
..... 990..... Ft West from Southeast Corner of Section
(Note: Locate well on Section Plat on reverse side)

Nearest lease or unit boundary line 990 feet.
County Decatur
Lease Name McKenna Well# 1-10

Domestic well within 330 feet: ☐ yes ☒ no
Municipal well within one mile: ☐ yes ☐ no

Depth to Bottom of fresh water 150 feet
Lowest usable water formation Unconsolidated Dolomite
Depth to Bottom of usable water 1475 feet
Surface pipe by Alternate: 1 ☐ 2 ☒
Surface pipe to be set 300 feet
Conductor pipe if any required feet
Ground surface elevation 2673 feet MSL
This Authorization Expires 1-1-86
Approved By 7-1-85 RCH for KONE


Title Drilling & Production Clerk

Must be filed with the K.C.C. five (5) days prior to commencing well
This card void if drilling not started within six (6) months of date received by K.C.C.

RECEIVED
STATE CORPORATION COMMISSION
17-1-85
JUL 01 1985
CONSERVATION DIVISION
Wichita, Kansas

Important procedures to follow :

A Regular Section of Land
1 Mile = 5,280 Ft.

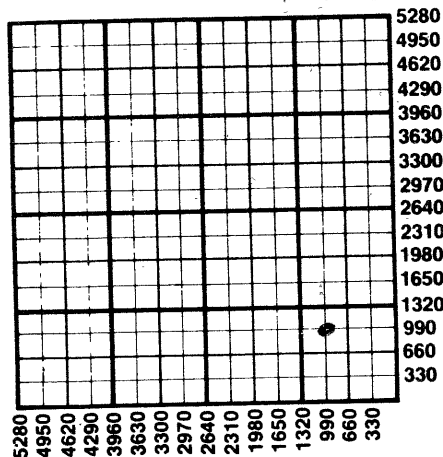

1. Notify District office before setting surface casing.
2. Set surface casing by circulating cement to the top.
3. File completion forms ACO-1 with K.C.C. within 90 days of well completion, following instructions on ACO-1, side 1, and including copies of wireline logs.
4. Notify District office 48 hours prior to old well workover or re-entry.
5. Prior to plugging, prepare a plugging plan, then obtain agreement from the appropriate district office for an approved plugging plan.
6. Submit plugging report (CP-4) to K.C.C. after plugging is completed.
7. Obtain an approved injection docket number before disposing of salt water.
8. Notify K.C.C. within 10 days when injection commences or terminates.
9. If an alternate 2 completion, cement in the production pipe from below any usable water to surface within 120 days of spud date.

State Corporation Commission of Kansas
Conservation Division
200 Colorado Derby Building
Wichita, Kansas 67202
(316) 263-3238