

15-039-60055-00-00

STATE OF KANSAS
STATE CORPORATION COMMISSION

All Information Completely
Make Required Affidavit
Mail or Deliver Report to:
Conservation Division
State Corporation Commission
800 Bittling Building
Wichita, Kansas

WELL PLUGGING RECORD

NORTH

Muirhead NE	NE	#1 SW	
Sec. 15-5-27W			

Locate well correctly on above
Section Plat

Decatur County. Sec. 15 Twp. 5 Rge. 27 (E) (W)
 Location as "NE/CNW $\frac{1}{4}$ SW $\frac{1}{4}$ " or footage from lines NE-NE-SW
 Lease Owner Harry Gore
 Lease Name Muirhead Well No. #1
 Office Address 400 Brown Bldg. Wichita, Kansas
 Character of Well (completed as Oil, Gas or Dry Hole) Dry Hole
 Date well completed April 4, 1952 19 52
 Application for plugging filed April 4 19 52
 Application for plugging approved April 4 19 52
 Plugging commenced April 4 4:00 P. M. 19 52
 Plugging completed April 4 12:00 P. M. 19 52
 Reason for abandonment of well or producing formation Dry Hole

If a producing well is abandoned, date of last production 19
 Was permission obtained from the Conservation Division or its agents before plugging was commenced? Yes Verbal

Name of Conservation Agent who supervised plugging of this well Eldon Petty
 Producing formation Depth to top Bottom Total Depth of Well 4160 Feet
 Show depth and thickness of all water, oil and gas formations.

OIL, GAS OR WATER RECORDS

CASING RECORD

Formation	Content	From	To	Size	Put In	Pulled Out
Post Rock Clay Shells		0	270'	8 5/8	270'	None
Kansas City		3749	3950		dry	dry
T. D. 4160						

Describe in detail the manner in which the well was plugged, indicating where the mud fluid was placed and the method or methods used in introducing it into the hole. If cement or other plugs were used, state the character of same and depth placed, from feet to feet for each plug set.

Stirred pits fill hole with heavy mud to 250'. Ran $\frac{1}{2}$ sack Hulls and 15 sacks cement. Filled hole with heavy muc to 40'. Set wood plug at 40'. Ran $\frac{1}{2}$ sack hulls and 10 sacks cement, filling to bottom of cellar.

(If additional description is necessary, use BACK of this sheet)

Name of Plugging Contractor Strain Drilling Co.
 Address 117 East 8th Street Box 188 Hays, Kansas

STATE OF Kansas, COUNTY OF Ellis, ss.
 T. C. Strain (employee of owner) or (owner or operator) of the above-described well,

being first duly sworn on oath, says: That I have knowledge of the facts, statements, and matters herein contained and the log of the above-described well as filed and that the same are true and correct. So help me God. T. C. Strain

(Signature) *T. C. Strain*


Box 188, Hays, Kansas (Address)

SUBSCRIBED AND SWORN to before me this 9th day of April, 1952

Deward A. Greiner
Notary Public.

My commission expires My Commission Expires Jan. 31, 1953

23-8390-s 6-51-20M

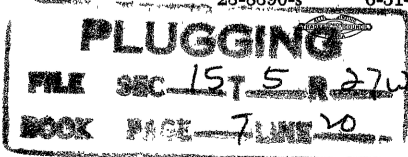

Rec'd 4-9-52