


STATE OF KANSAS
STATE CORPORATION COMMISSION

WELL PLUGGING RECORD

Give All Information Completely
Make Required Affidavit
Mail or Deliver Report to
Conservation Division
State Corporation Comm.
245 North Water
Wichita, KS 67202

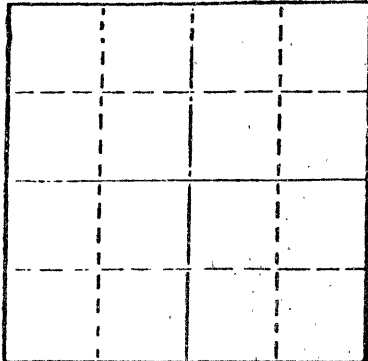

Locate well correctly on above
Section Plat

Decatur County. Sec. 12 Twp. 5S Rge. 27W E/W
Location as "NE/CNW $\frac{1}{4}$ SW $\frac{1}{4}$ " or footage from lines
NE SW SW
Lease Owner Kimbark Oil & Gas
Lease Name Hardesty Well No. 1
Office Address 1580 Lincoln, Suite 700, Denver, CO 80203
Character of Well (Completed as Oil, Gas or Dry Hole)
Dry Hole
Date Well completed 1-2-82 19
Application for plugging filed 1-2-82 19
Application for plugging approved 1-2-82 19
Plugging commenced 1-2-82 19
Plugging completed 1-2-82 19
Reason for abandonment of well or producing formation
Dry Hole
If a producing well is abandoned, date of last production 19.

Was permission obtained from the Conservation Division or
its agents before plugging was commenced? yes

Name of Conservation Agent who supervised plugging of this well Carl Goodrow
Producing formation Depth to top Bottom Total Depth of Well 3820'
Show depth and thickness of all water, oil and gas formations.

OIL, GAS OR WATER RECORDS

CASING RECORD

FORMATION	CONTENT	FROM	TO	SIZE	PUT IN	PULLED OUT
surface				8-5/8	550	none

Describe in detail the manner in which the well was plugged, indicating where the mud fluid
was placed and the method or methods used in introducing it into the hold. If cement or other
plugs were used, state the character of same and depth placed, from feet to
feet for each plug set.

1st plug @ 1300 w/70 sx
2nd plug @ 575 w/50 sx
3rd plug @ 40 w/10 sx
10 sx in rat hole
5 sx in mouse hole


RECEIVED
STATE CORPORATION COMMISSION

FEB - 1 1982

CONSERVATION DIVISION 2-1-82
Wichita, Kansas

(If additional description is necessary, use BACK of this form)
Name of Plugging Contractor Murfin Drilling Co.

STATE OF Kansas COUNTY OF Sedgwick, ss.
David L. Murfin, Drlg. Mgr. (employee of owner) or (owner or operator)
of the above-described well, being first duly sworn on oath, says: That I have knowledge of
the facts, statements, and matters herein contained and the log of the above-described well
as filed and that the same are true and correct. So help me God.

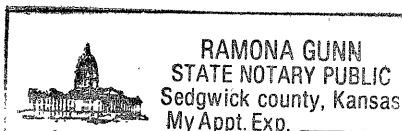

(Signature) David L. Murfin, 617 Union Center Bldg.
(Address) Wichita, KS 67202

SUBSCRIBED AND SWORN TO before me this 14th day of January, 19 82

My commission expires Jan. 25, 1984

Ramona Gunn Notary Public.