

15-039-20160-00-00


STATE OF KANSAS  
STATE CORPORATION COMMISSION

Form CP-4

Give All Information Completely  
Make Required Affidavit  
Mail or Deliver Report to:  
Conservation Division  
State Corporation Commission  
212 No. Market  
Wichita, Kansas

WELL PLUGGING RECORD

NORTH

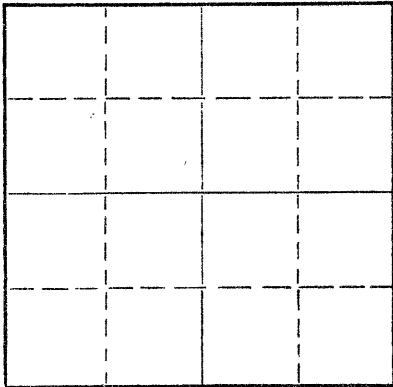

Locate well correctly on above  
Section Plat

Decatur County. Sec. 12 Twp. 5S Rge. 27 (E) (W)  
Location as "NE/CNW/SW" or footage from lines SE NW NW  
Lease Owner Murfin Drilling, Consolidated O & G Co. & Executive Pet.  
Lease Name Carter-Colip Well No. 1  
Office Address 617 Union Center, Wichita, Kansas 67202  
Character of Well (completed as Oil, Gas or Dry Hole) Dry Hole  
Date well completed May 21 19 70  
Application for plugging filed May 21 19 70  
Application for plugging approved May 21 19 70  
Plugging commenced May 21 19 70  
Plugging completed May 21 19 70  
Reason for abandonment of well or producing formation \_\_\_\_\_

If a producing well is abandoned, date of last production \_\_\_\_\_ 19 \_\_\_\_  
Was permission obtained from the Conservation Division or its agents before plugging was commenced? Yes

Name of Conservation Agent who supervised plugging of this well W. L. Nichols  
Producing formation \_\_\_\_\_ Depth to top \_\_\_\_\_ Bottom \_\_\_\_\_ Total Depth of Well \_\_\_\_\_ Feet  
Show depth and thickness of all water, oil and gas formations.

OIL, GAS OR WATER RECORDS

CASING RECORD

FORMATION	CONTENT	FROM	TO	SIZE	PUT IN	PULLED OUT
				8 5/8"	248'	None

Describe in detail the manner in which the well was plugged, indicating where the mud fluid was placed and the method or methods used in introducing it into the hole. If cement or other plugs were used, state the character of same and depth placed, from \_\_\_\_\_ feet to \_\_\_\_\_ feet for each plug set.

1st Plug @ 1375 w/100 sacks  
2nd Plug @ 275' w/25 sacks  
3rd Plug @ 40' w/10 sacks


RECEIVED  
STATE CORPORATION COMMISSION  
JUN 8 1970  
CONSERVATION DIVISION  
Wichita, Kansas

6-8-70

(If additional description is necessary, use BACK of this sheet)  
Name of Plugging Contractor Murfin Drilling Company  
Address 617 Union Center, Wichita, Kansas 67202

STATE OF Kansas, COUNTY OF Sedgwick, ss.  
James R. Daniels (employee of owner) or (owner or operator) of the above-described well, being first duly sworn on oath, says: That I have knowledge of the facts, statements, and matters herein contained and the log of the above-described well as filed and that the same are true and correct. So help me God.

(Signature) James R. Daniels  
617 Union Center, Wichita, Kansas  
(Address)

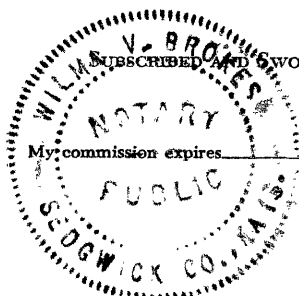

Subscribed and sworn to before me this 5th day of June 19 70  
February 7, 1971  
Wilma V. Brokes  
Notary Public.