


15-039-00508-00-00

STATE OF KANSAS  
STATE CORPORATION COMMISSION

Give All Information Completely  
Make Required Affidavit  
Mail or Deliver Report to:  
Conservation Division  
State Corporation Commission  
211 No. Broadway  
Wichita, Kansas

WELL PLUGGING RECORD

NORTH

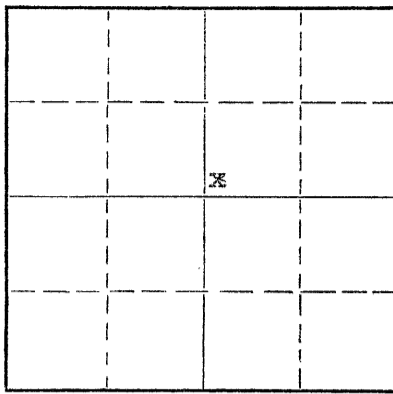

Locate well correctly on above  
Section Plat

Decatur County. Sec. 11 Twp. 5S Rge. (E) 27 (W)  
Location as "NE/CNW/SW" or footage from lines SW/4 SW/4 NE/4  
Lease Owner R. W. Shields  
Lease Name Koerperich Well No. 2  
Office Address Rule Building, Wichita, Kansas  
Character of Well (completed as Oil, Gas or Dry Hole) dry hole  
Date well completed November 29 1956  
Application for plugging filed November 29 1956  
Application for plugging approved November 29 1956  
Plugging commenced November 29 1956  
Plugging completed November 29 1956  
Reason for abandonment of well or producing formation dry hole

If a producing well is abandoned, date of last production 19  
Was permission obtained from the Conservation Division or its agents before plugging was commenced? Yes

Name of Conservation Agent who supervised plugging of this well Eldon Petty  
Producing formation - Depth to top - Bottom - Total Depth of Well - Feet  
Show depth and thickness of all water, oil and gas formations.

OIL, GAS OR WATER RECORDS

CASING RECORD

FORMATION	CONTENT	FROM	TO	SIZE	PUT IN	PULLED OUT

Describe in detail the manner in which the well was plugged, indicating where the mud fluid was placed and the method or methods used in introducing it into the hole. If cement or other plugs were used, state the character of same and depth placed, from   feet to   feet for each plug set.

Filled hole with heavy mud from 3656 feet to 230 feet. Set plug at 230 feet. Dumped one-half sack of hulls and fifteen sacks of cement on plug and completed filling hole with heavy mud to 40 feet. Set second plug at 40 feet. Dumped one-half sack of hulls and 10 sacks of cement on plug to fill to bottom of cellar.

(If additional description is necessary, use BACK of this sheet)  
Name of Plugging Contractor Barnett Drilling, Inc.  
Address 409 First National Bank Bldg., Wichita, Kansas

STATE OF Kansas, COUNTY OF Sedgwick, ss.  
F. R. Stubblefield Contractor,  
(employee of owner) or (owner or operator) of the above-described well, being first duly sworn on oath, says: That I have knowledge of the facts, statements, and matters herein contained and the log of the above-described well as filed and that the same are true and correct. So help me God.

(Signature) F. R. Stubblefield  
First National Bank Building, Wichita, Kansas  
(Address)

SUBSCRIBED AND SWORN TO before me this 3rd day of December, 1956

My commission expires February 27, 1960  
Michael J. Willis Notary Public.

PLUGGING  
WELL SEC 11 T. 5 R. 27W  
BOOK PAGE 121 LINE 22

RECEIVED  
STATE CORPORATION COMMISSION  
DEC 4 - 1956  
CONSERVATION DIVISION  
Wichita, Kansas  
12-4-56