


19-039-00051-00-00

Give All Information Completely
Make Required Affidavit
Mail or Deliver Report to:
Conservation Division
State Corporation Commission
800 Bitting Building
Wichita, Kansas

WELL PLUGGING RECORD

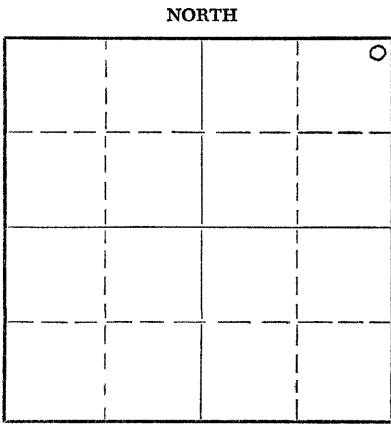

Locate well correctly on above
Section Plat

Decatur

County. Sec. 15 Twp. 5 Rge. 27 (E) W (W)

Location as "NE/CNW/SW" or footage from lines NE NE NE

Lease Owner Harry Gore

Lease Name Boland Well No. 1

Office Address 400 Brown Building, Wichita 2, Kansas

Character of Well (completed as Oil, Gas or Dry Hole) Dry Hole

Date well completed 10-24 19 52

Application for plugging filed 10-24 19 52

Application for plugging approved 10-24 19 52

Plugging commenced 10-24 19 52

Plugging completed 10-24 19 52

Reason for abandonment of well or producing formation Dry Hole

If a producing well is abandoned, date of last production _____ 19 _____

Was permission obtained from the Conservation Division or its agents before plugging was commenced? yes

Name of Conservation Agent who supervised plugging of this well Eldon Petty

Producing formation _____ Depth to top _____ Bottom _____ Total Depth of Well 3880 Feet

Show depth and thickness of all water, oil and gas formations.

OIL, GAS OR WATER RECORDS

CASING RECORD

FORMATION	CONTENT	FROM	TO	SIZE	PUT IN	PULLED OUT
Surface	Pipe	0	251	8-5/8	251	0

Describe in detail the manner in which the well was plugged, indicating where the mud fluid was placed and the method or methods used in introducing it into the hole. If cement or other plugs were used, state the character of same and depth placed, from _____ feet to _____ feet for each plug set.

Set first plug at 240', 1/2 sack of
hulls and 15 sacks of cement, filled
hole to 40'.
Set second plug at 40', cemented with
10 sacks of cement.

RECEIVED

11-1-52

(If additional description is necessary, use BACK of this sheet)
Name of Plugging Contractor Empire Drilling Company
Address 1121 Union National Bank Building, Wichita 2, Kansas

STATE OF Kansas, COUNTY OF Sedgwick, ss.
I, Dan J. Kornfeld,

being first duly sworn on oath, says: That I have knowledge of the facts, statements, and matters herein contained and the log of the above-described well as filed and that the same are true and correct. So help me God.

(Signature) Dan J. Kornfeld
Dan J. Kornfeld
1121 Union Nat'l. Bk. Bldg., Wichita, Ks.
(Address)

SUBSCRIBED AND SWORN TO before me this 30th day of October, 1952

Mary Steinmeier
Notary Public.

My commission expires May 5, 1956

