


STATE OF KANSAS
STATE CORPORATION COMMISSION

Give All Information Completely
Make Required Affidavit
Mail or Deliver Report to:
Conservation Division
State Corporation Commission
800 Bitting Building
Wichita, Kansas

15-039-00511-00-00
WELL PLUGGING RECORD

NORTH

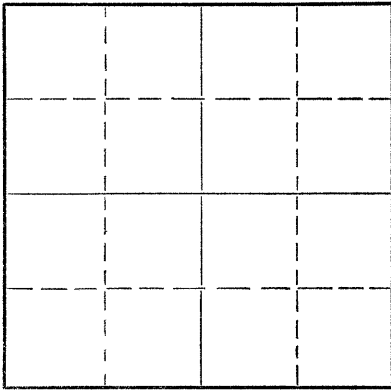

Locate well correctly on above
Section Plat

Decatur County. Sec. 14 Twp. 5 S Rge. 27 ~~(W)~~ W (W)
Location as "NE/CNW/SW" or footage from lines NW 1/4 SW 1/4 SW 1/4
Lease Owner R. W. Shields, et al
Lease Name Maher Feely Well No. 1
Office Address Sharp Building, Lincoln, Nebraska
Character of Well (completed as Oil, Gas or Dry Hole) Dry Hole
Date well completed November 23, 19 53
Application for plugging filed November 23, 19 53
Application for plugging approved November 23, 19 53
Plugging commenced November 23, 19 53
Plugging completed November 23, 19 53
Reason for abandonment of well or producing formation Dry Hole

If a producing well is abandoned, date of last production _____ 19 ____
Was permission obtained from the Conservation Division or its agents before plugging was commenced? Yes

Name of Conservation Agent who supervised plugging of this well Eldon Petty
Producing formation _____ Depth to top _____ Bottom _____ Total Depth of Well 3915 Feet
Show depth and thickness of all water, oil and gas formations.

OIL, GAS OR WATER RECORDS

CASING RECORD

FORMATION	CONTENT	FROM	TO	SIZE	PUT IN	PULLED OUT
		<u>-0-</u>	<u>212</u>	<u>8 5/8"</u>	<u>212</u>	<u>-0-</u>

Describe in detail the manner in which the well was plugged, indicating where the mud fluid was placed and the method or methods used in introducing it into the hole. If cement or other plugs were used, state the character of same and depth placed, from _____ feet to _____ feet for each plug set.

Filled hole with heavy mud from 3915 feet to 210 feet. Set plug at 210 feet and filled surface pipe with 15 sacks of cement and 1/2 sack of hulls to 40 feet. Set second plug at 40 feet and filled casing with 10 sacks of cement and 1/2 sack of hulls to bottom of cellar.

(If additional description is necessary, use BACK of this sheet)

Name of Plugging Contractor Barnett Drilling, Inc.
Address 623 First National Bank Bldg., Wichita, Kansas

11-28-53

STATE OF Kansas, COUNTY OF Sedgwick, ss.
F. R. Stubblefield

(employee or owner or operator) of the above-described well, being first duly sworn on oath, says: That I have knowledge of the facts, statements, and matters herein contained and the log of the above-described well as filed and that the same are true and correct. So help me God.

(Signature) F. R. Stubblefield
623 First National Bank Bldg., Wichita, Kansas
(Address)

SUBSCRIBED AND SWORN TO before me this 27th day of November, 19 53

My commission expires February 27, 1956.

Mildred F. Willis
Notary Public.

