

15-039-00201-06-00

Give All Information Completely
Make Required Affidavit
Mail or Deliver Report to:
Conservation Division
State Corporation Commission
211 No. Broadway
Wichita, Kansas

WELL PLUGGING RECORD

Decatur County, Sec. 14 Twp. 5S Rge. 27 (W)

Location as "NE/CNW/SW" or footage from lines C NW NW

Lease Owner Rains & Williamson Oil Co.

Lease Name Gillespie Well No. 1

Office Address 412 Union Center, Wichita 2, Kansas

Character of Well (completed as Oil, Gas or Dry Hole) dry hole

Date well completed 9/27/62 19

Application for plugging filed 9/27/62 19

Application for plugging approved 9/27/62 19


Plugging commenced 9/27/62 19

Plugging completed 9/27/62 19

Reason for abandonment of well or producing formation no oil or gas found in commercial quantities

If a producing well is abandoned, date of last production _____ 19

Was permission obtained from the Conservation Division or its agents before plugging was commenced? yes

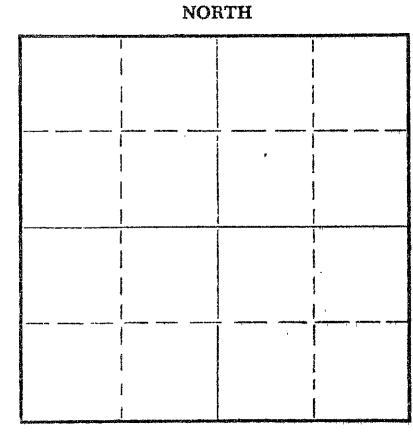

Locate well correctly on above Section Plat

Name of Conservation Agent who supervised plugging of this well Eldon Petty

Producing formation _____ Depth to top _____ Bottom _____ Total Depth of Well 3885 Feet

Show depth and thickness of all water, oil and gas formations.

OIL, GAS OR WATER RECORDS

CASING RECORD

FORMATION	CONTENT	FROM	TO	SIZE	PUT IN	PULLED OUT
				8 5/8"	222'	none

Describe in detail the manner in which the well was plugged, indicating where the mud fluid was placed and the method or methods used in introducing it into the hole. If cement or other plugs were used, state the character of same and depth placed, from _____ feet to _____ feet for each plug set.

Set plug at 550' with 20 sacks cement, filled hole to 180' rotary mud, plug No. 2 180' with 20 sacks cement, filled hole to 40' rotary mud and 10 sacks to base of cellar.

RECEIVED
STATE CORPORATION COMMISSION
OCT 2 1962
CONSERVATION DIVISION
Wichita, Kansas

10-2-62

(If additional description is necessary, use BACK of this sheet)

Name of Plugging Contractor Rains & Williamson Oil Co.
Address 412 Union Center, Wichita 2, Kansas

STATE OF KANSAS, COUNTY OF SEDGWICK, ss.
Wilson Rains - Partner (owner or operator) of the above-described

well, being first duly sworn on oath, says: That I have knowledge of the facts, statements, and matters herein contained and the log of the above-described well as filed and that the same are true and correct. So help me God.

(Signature) Wilson Rains
Wilson Rains - Partner
412 Union Center, Wichita, Kansas
(Address)

SUBSCRIBED AND SWORN TO before me this 1st day of October, 1962

Janet Johnson
Notary Public.

My commission expires January 25, 1965

