


WELL PLUGGING RECORD

Give All Information Completely
Make Required Affidavit
Mail or Deliver Report to:
Conservation Division
State Corporation Commission
212 No. Market
Wichita, Kansas

NORTH

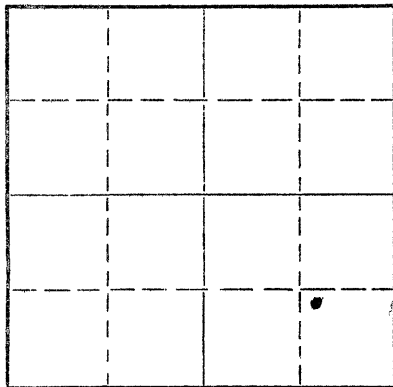

Locate well correctly on above
Section Plat

Decatur County. Sec. 15 Twp. 5 Rge. 28 (E) (W)
Location as "NE/CNW/SW" or footage from lines N $\frac{1}{2}$ of SE $\frac{1}{4}$ of SE $\frac{1}{4}$
Lease Owner ~~Rex Ritter~~ SPACE AGE VALUABLE ENERGY, INC.
Lease Name Ritter No. I Well No. I
Office Address Box 434 Hoxie, Kansas 67740
Character of Well (completed as Oil, Gas or Dry Hole) Dry Hole
Date well completed August 26, 1975
Application for plugging filed August 26 1975
Application for plugging approved Sept. 3 1975
Plugging commenced August 26 1975
Plugging completed August 26 1975
Reason for abandonment of well or producing formation Dry Hole

If a producing well is abandoned, date of last production 19____
Was permission obtained from the Conservation Division or its agents before plugging was commenced? yes

Name of Conservation Agent who supervised plugging of this well Gilbert Bathazer
Producing formation _____ Depth to top _____ Bottom _____ Total Depth of Well 4485 Feet
Show depth and thickness of all water, oil and gas formations.

OIL, GAS OR WATER RECORDS

CASING RECORD

FORMATION	CONTENT	FROM	TO	SIZE	PUT IN	PULLED OUT
Surface		(0)	276'	8 5/8 "	276	0

Describe in detail the manner in which the well was plugged, indicating where the mud fluid was placed and the method or methods used in introducing it into the hole. If cement or other plugs were used, state the character of same and depth placed, from _____ feet to _____ feet for each plug set.

Filled hole with chemical mud. Well was logged by Petro-Log.
Mixed 50/50 common and Pozmix cement and six per cent gel--100 sacks.
Drill pipe was lowered to 1300 feet and Allied Cementing Company, Inc., placed cement plug at 1300 feet, using 70 sacks of cement mixture. 1300'-1510'
At 260 feet (17 feet into the bottom of the surface casing) 20 sacks of cement mixture was injected. 260'-340'.
Wooden bridge plug was set at 40 feet with 1 sack of cottonseed hulls below plug.
Ten sacks of cement mixture was pumped in from 40 feet to surface.


RECEIVED
STATE CORPORATION COMMISSION

SEP 12 1975
09-12-1975
CONSULTING ENGINEER
Wichita, Kansas

Name of Plugging Contractor Allied Cementing Company, Inc.
Address P. O. Box 31 Russell, Kansas 67665

STATE OF Kansas, COUNTY OF Sheridan, ss.
Maurice B. Greiser (employee of owner) or (owner or operator) of the above-described well, being first duly sworn on oath, says: That I have knowledge of the facts, statements, and matters herein contained and the log of the above-described well as filed and that the same are true and correct. So help me God. *Maurice Greiser Sec.*
(Signature) Space Age Valuable Energy, Inc.
Box 434 Hoxie, Kansas 67740
(Address)

SUBSCRIBED AND SWORN TO before me this 11 day of September, 1975

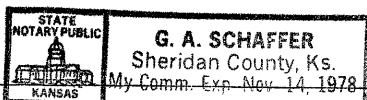

My commission expires _____

Notary Public.