


15-039-00153-00-00

STATE OF KANSAS
STATE CORPORATION COMMISSION

Give All Information Completely
Make Required Affidavit
Mail or Deliver Report to:
Conservation Division
State Corporation Commission
800 Bittling Building
Wichita, Kansas

WELL PLUGGING RECORD

NORTH

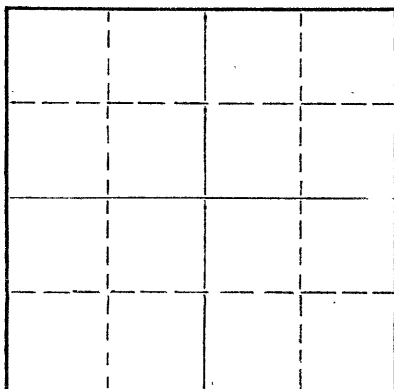

Locate well correctly on above
Section Plat

Decatur County. Sec. 11 Twp. 5S Rge. 27 (E) W (W)
Location as "NE/CNW/SW" or footage from lines NW/4 NW/4 SE/4
Lease Owner R. W. Shields
Lease Name Feely "B" Well No. 1
Office Address Rule Building, Wichita, Kansas
Character of Well (completed as Oil, Gas or Dry Hole) Dry hole
Date well completed November 20 19 56
Application for plugging filed November 20 19 56
Application for plugging approved November 20 19 56
Plugging commenced November 20 19 56
Plugging completed November 20 19 56
Reason for abandonment of well or producing formation Dry hole

If a producing well is abandoned, date of last production 19
Was permission obtained from the Conservation Division or its agents before plugging was commenced? Yes

Name of Conservation Agent who supervised plugging of this well Eldon Petty
Producing formation Depth to top Bottom Total Depth of Well 3693 Feet
Show depth and thickness of all water, oil and gas formations.

OIL, GAS OR WATER RECORDS

CASING RECORD

FORMATION	CONTENT	FROM	TO	SIZE	PUT IN	PULLED OUT

Describe in detail the manner in which the well was plugged, indicating where the mud fluid was placed and the method or methods used in introducing it into the hole. If cement or other plugs were used, state the character of same and depth placed, from feet to feet for each plug set.

Filled hole with heavy mud from 3693 feet to 210 feet. Set plug at 210 feet. Dumped 1/2 sack of hulls and 15 sacks of cement on plug and completed filling hole with heavy mud to 40 feet. Set second plug at 40 feet. Dumped 1/2 sack of hulls and 10 sacks of cement on plug to fill to bottom of cellar.

11-27-56
CORRECTED
Wichita

(If additional description is necessary, use BACK of this sheet)

Name of Plugging Contractor Barnett Drilling, Inc.
Address 409 First National Bank Bldg., Wichita, Kansas

STATE OF Kansas COUNTY OF Sedgwick ss.
F. R. Stubblefield (employee of Contractor) of the above-described well, being first duly sworn on oath, says: That I have knowledge of the facts, statements, and matters herein contained and the log of the above-described well as filed and that the same are true and correct. So help me God.

(Signature) F. R. Stubblefield
(Address)

SUBSCRIBED AND SWORN to before me this 26th day of November, 1956

Mildred F. Willis
Notary Public.

My commission expires February 27, 1960

PLUGGING
FILED SEC 11 T 5 R 27W
BOOK PAGE 119 LINE 25