

15-039-00048-00-01

STATE OF KANSAS
STATE CORPORATION COMMISSION


Form CP-4

WELL PLUGGING RECORD

Give All Information Completely
Make Required Affidavit
Mail or Deliver Report to:
Conservation Division
State Corporation Commission
212 No. Market
Wichita, Kansas 67202

Decatur County. Sec. 2 Twp. 5 Rge. (E) 27(W)

Location as "NE/CNW/SW" or footage from lines SE SE SW
Lease Owner Continental Oil Company
Lease Name Feely Well No. 5
Office Address Box 267, Great Bend, Kansas 67530
Character of Well (completed as Oil, Gas or Dry Hole) input well
Date well completed 19
Application for plugging filed 19
Application for plugging approved 19
Plugging commenced December 2 1971
Plugging completed December 17 1971
Reason for abandonment of well or producing formation no longer needed

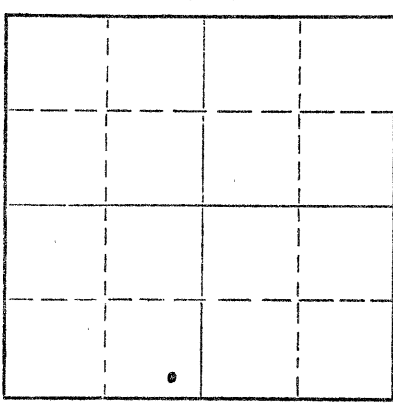

Locate well correctly on above
Section Plat

If a producing well is abandoned, date of last production 19
Was permission obtained from the Conservation Division or its agents before plugging was commenced? YES

Name of Conservation Agent who supervised plugging of this well W. L. Nichols
Producing formation Depth to top Bottom Total Depth of Well 4040 Feet
Show depth and thickness of all water, oil and gas formations.

OIL, GAS OR WATER RECORDS

CASING RECORD

FORMATION	CONTENT	FROM	TO	SIZE	PUT IN	PULLED OUT
		0	249'	10 3/4"	249'	none
		0	3730'	5 1/2"	3730'	1219.08

Describe in detail the manner in which the well was plugged, indicating where the mud fluid was placed and the method or methods used in introducing it into the hole. If cement or other plugs were used, state the character of same and depth placed, from feet to feet for each plug set.

Sanded back to 3550' and dumped 5 sacks of cement.

Plugged well with 5 sacks of hulls, 50 sacks of gel and 195 sacks of cement.

RECEIVED
STATE CORPORATION COMMISSION
JAN 3 1972
CONSERVATION DIVISION
Wichita, Kansas

Name of Plugging Contractor PIPE PULLERS, INC. (If additional description is necessary, use BACK of this sheet)
Address Box 486, Ellinwood, Kansas 67526

STATE OF KANSAS, COUNTY OF BARTON, ss.
Evelyn Roth (employee of owner) or owner or operator

well, being first duly sworn on oath, says: That I have knowledge of the facts, statements, and matters herein contained and the log of the above-described well as filed and that the same are true and correct. So help me God.

(Signature) Evelyn Roth
Ellinwood, Kansas (Address)

SUBSCRIBED AND SWORN TO before me this 30th day of December, 1971

My commission expires Feb. 10, 1975
George Meyer Notary Public