

15-039-00543-00-01


STATE OF KANSAS
STATE CORPORATION COMMISSION

Form CP-4

WELL PLUGGING RECORD

Give All Information Completely
Make Required Affidavit
Mail or Deliver Report to:
Conservation Division
State Corporation Commission
212 No. Market
Wichita, Kansas 67202

NORTH

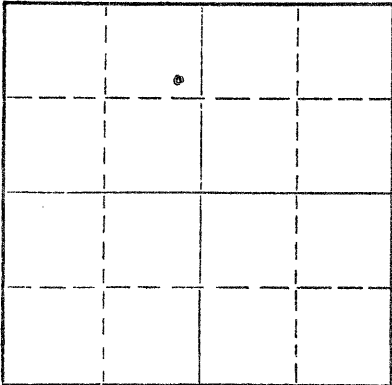

Locate well correctly on above
Section Plat

Decatur County. Sec. 11 Twp. 5 Rge. (E) 27(W)
Location as "NE/CNW/SW" or footage from lines SE NE NW
Lease Owner Continental Oil Company
Lease Name Feely Well No. 8
Office Address Box 267, Great Bend, Kansas
Character of Well (completed as Oil, Gas or Dry Hole) oil & OR
Date well completed 19
Application for plugging filed 19
Application for plugging approved 19
Plugging commenced December 18 19 71
Plugging completed December 22 19 71
Reason for abandonment of well or producing formation depleted

If a producing well is abandoned, date of last production 19
Was permission obtained from the Conservation Division or its agents before plugging was commenced? YES

Name of Conservation Agent who supervised plugging of this well W. L. Nichols
Producing formation Depth to top Bottom Total Depth of Well 3630 Feet
Show depth and thickness of all water, oil and gas formations.

OIL, GAS OR WATER RECORDS

CASING RECORD

FORMATION	CONTENT	FROM	TO	SIZE	PUT IN	PULLED OUT
		0	247'	8 5/8"	247'	none
		0	3648'	5 1/2"	3648'	936.31

Describe in detail the manner in which the well was plugged, indicating where the mud fluid was placed and the method or methods used in introducing it into the hole. If cement or other plugs were used, state the character of same and depth placed, from feet to feet for each plug set.

Sanded back to 3550' and dumped 5 sacks of cement.
Plugged well with 5 sacks of hulls, 35 sacks of gel and 150 sacks of cement.

RECEIVED
STATE CORPORATION COMMISSION
JAN 4 1972
CONSERVATION DIVISION
Wichita, Kansas

1-4-72

Name of Plugging Contractor PIPE PULLERS, INC.
Address Box 486, Ellinwood, Kansas

STATE OF KANSAS, COUNTY OF BARTON, ss.
Evelyn Roth (employee of owner) or (owner or operator) of the above-described

well, being first duly sworn on oath, says: That I have knowledge of the facts, statements, and matters herein contained and the log of the above-described well as filed and that the same are true and correct. So help me God.

(Signature) Evelyn Roth
Ellinwood, Kansas

SUBSCRIBED AND SWORN TO before me this 31 day of December, 19 71

My commission expires Feb. 10, 1975
George A. Meyer Notary Public.