

15-039-~~1250~~-00-28 00575

STATE OF KANSAS  
STATE CORPORATION COMMISSION


Form CP-4

WELL PLUGGING RECORD

Give All Information Completely  
Make Required Affidavit  
Mail or Deliver Report to:  
Conservation Division  
State Corporation Commission  
212 No. Market  
Wichita, Kansas 67202

Decatur County, Sec. 11 Twp. 5 Rge. (E) 27(W)

Location as "NE/CNWxSWx" or footage from lines NW NW NE  
Lease Owner Continental Oil Company  
Lease Name Feely LKC Unit Well No. 6  
Office Address Box 267, Great Bend, Kansas  
Character of Well (completed as Oil, Gas or Dry Hole) oil gas  
Date well completed 19  
Application for plugging filed 19  
Application for plugging approved 19  
Plugging commenced December 19 19 71  
Plugging completed December 22 19 71  
Reason for abandonment of well or producing formation depleted

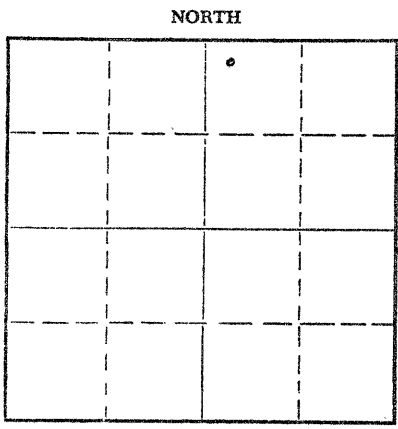

Locate well correctly on above Section Plat

If a producing well is abandoned, date of last production 19  
Was permission obtained from the Conservation Division or its agents before plugging was commenced? yes

Name of Conservation Agent who supervised plugging of this well W. L. Nichols  
Producing formation \_\_\_\_\_ Depth to top \_\_\_\_\_ Bottom \_\_\_\_\_ Total Depth of Well 3840 Feet  
Show depth and thickness of all water, oil and gas formations.

OIL, GAS OR WATER RECORDS

CASING RECORD

FORMATION	CONTENT	FROM	TO	SIZE	PUT IN	PULLED OUT
		0	209'	8 5/8"	209'	none
		0	3679'	5 1/2"	3679'	920.21

Describe in detail the manner in which the well was plugged, indicating where the mud fluid was placed and the method or methods used in introducing it into the hole. If cement or other plugs were used, state the character of same and depth placed, from \_\_\_\_\_ feet to \_\_\_\_\_ feet for each plug set.

Sanded back to 3625' and dumped 5 sacks of cement.  
Plugged well with 5 sacks of hulls, 35 sacks of gel and 150 sacks of cement.

RECEIVED  
STATE CORPORATION COMMISSION  
JAN 3 1972  
CONSERVATION DIVISION  
Wichita, Kansas 1-3-72

Name of Plugging Contractor PIPE PULLERS, INC.  
Address Box 486, Ellinwood, Kansas

STATE OF KANSAS, COUNTY OF BARTON, ss. Evelyn Roth

(employee of owner) or (owner or operator) of the above-described well, being first duly sworn on oath, says: That I have knowledge of the facts, statements, and matters herein contained and the log of the above-described well as filed and that the same are true and correct. So help me God.

(Signature) Evelyn Roth  
Ellinwood, Kansas

SUBSCRIBED AND SWORN TO before me this 30th day of December, 19 71

My commission expires Feb. 10, 1975  
Seage A Meyer Notary Public