


STATE OF KANSAS
STATE CORPORATION COMMISSION

Give All Information Completely
Make Required Affidavit
Mail or Deliver Report to:
Conservation Division
State Corporation Commission
800 Bitting Building
Wichita, Kansas

WELL PLUGGING RECORD

Decatur County. Sec. 35 Twp. 5S Rge. 27 (E) W (W)
Location as "NE/CNW $\frac{1}{4}$ SW $\frac{1}{4}$ " or footage from lines NW SW SE
Lease Owner C-G Drilling Co.
Lease Name McLeod Well No. 1
Office Address 206 Union National Bank Bldg.
Character of Well (completed as Oil Gas or Dry Hole)
Date well completed 5-19-52 19
Application for plugging filed 5-19-52 19
Application for plugging approved 5-19-52 19
Plugging commenced 5-19-52 19
Plugging completed 5-19-52 19
Reason for abandonment of well or producing formation Too low structurally

NORTH

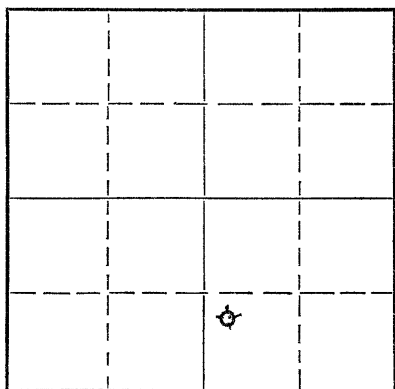

Locate well correctly on above
Section Plat

If a producing well is abandoned, date of last production: 19
Was permission obtained from the Conservation Division or its agents before plugging was commenced? Yes

Name of Conservation Agent who supervised plugging of this well Eldon Petty, Hays, Kansas
Producing formation Depth to top Bottom Total Depth of Well Feet
Show depth and thickness of all water, oil and gas formations.

OIL, GAS OR WATER RECORDS

CASING RECORD

Formation	Content	From	To	Size	Put In	Pulled Out
				8-5/8"	154'	-

Describe in detail the manner in which the well was plugged, indicating where the mud fluid was placed and the method or methods used in introducing it into the hole. If cement or other plugs were used, state the character of same and depth placed, from feet to feet for each plug set.

Filled with drilling mud to 152'. Set plug. Put in 15 sacks cement, 1/2 sack hulls; pumped full of mud to 35'. Set plug. Filled to top with 10 sacks cement.

RECEIVED
STATE CORPORATION COMMISSION
JUN 6 - 1952
CONSERVATION DIVISION
Wichita, Kansas

Name of Plugging Contractor Lohmann-Johnson Drilling Co.
Address Evansville, Indiana

STATE OF KANSAS, COUNTY OF SEDGWICK, ss.
R. A. COOK (Employer or owner) of the above-described well,
being first duly sworn on oath, says: That I have knowledge of the facts, statements, and matters herein contained and the log of the above-described well as filed and that the same are true and correct. So help me God.

(Signature) R A Cook

(Address)

SUBSCRIBED AND SWORN to before me this 24th day of May 1952

Wicky Fritz
Notary Public.

My commission expires June 25, 1955

PLUGGING
FILE SEC 35 T 5 R 27 W
BOOK PAGE 18 LINE 4