


WELL PLUGGING RECORD

OR 15-137-00029-00-00
FORMATION PLUGGING RECORD

Give All Information Completely
Make Required Affidavit
Mail or Deliver Report to:
Conservation Division
State Corporation Commission
800 Bittling Building
Wichita, Kansas

Strike out upper line
when reporting plugging
of formations.

NORTH

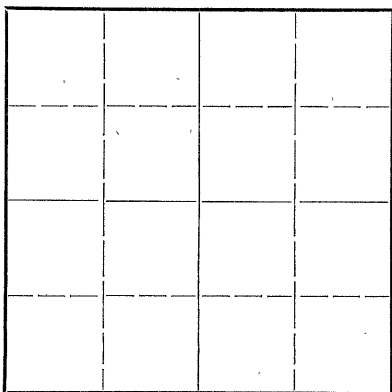

Locate well correctly on above
Section Plat

Norton County. Sec. 35 Twp. 5 Rge. 111 (E) 21 (W)
Location as "NE 1/4 NW 1/4 SW 1/4" or footage from lines. NE NE SW

Lease Owner. D. G. Hansen
Lease Name. Sullivan Well No. 1
Office Address. Logan, Ks.

Character of Well (completed as Oil, Gas or Dry Hole) Dry Hole
Date well completed. 19
Application for plugging filed. 12-13-46 19
Application for plugging approved. 12-13-46 19
Plugging commenced. 12-4-46 19
Plugging completed. 12-4-46 19
Reason for abandonment of well or producing formation. Dry Hole

If a producing well is abandoned, date of last production. Dry Hole 19
Was permission obtained from the Conservation Division or its agents before plugging was commenced? Yes

Name of Conservation Agent who supervised plugging of this well. H. W. Kerr
Producing formation. Depth to top. Bottom. Total Depth of Well. 3659 Feet

Show depth and thickness of all water, oil and gas formations.

OIL, GAS OR WATER RECORDS

CASING RECORD

Formation	Content	From	To	Size	Put In	Pulled Out

Describe in detail the manner in which the well was plugged, indicating where the mud fluid was placed and the method or methods used in introducing it into the hold. If cement or other plugs were used, state the character of same and depth placed, from _____ feet to _____ feet for each plug set.

The hole was filled with heavy mud 3659 ft. to bridge at 175'. Cement 175' to 135', 20 sacks. Mud 135' to 15'. Cement into base of cellar 10 sacks. 180' of 10 3/4 pipe cemented and left in hole. 03-15-1948

(If additional description is necessary, use BACK of this sheet)

Correspondence regarding this well should be addressed to Mr. D. G. Hanson
Address. Logan, Ks.

STATE OF Kansas COUNTY OF Phillips, ss.
Hugh M. King (employee of owner) or (owner or operator) of the above-described well,
being first duly sworn on oath, says: That I have knowledge of the facts, statements, and matters herein contained and the log of the above-described well as filed and that the same are true and correct. So help me God.

(Signature) Hugh M. King
Logan, Kansas (Address)

SUBSCRIBED AND SWORN to before me this 12th day of March, 1948

Notary Public.

My commission expires 12-11-51

PLUGGING
FILE SEC 35 T 5 R 21 W
BOOK PAGE 86 LINE 17