

**KANSAS CORPORATION COMMISSION
OIL & GAS CONSERVATION DIVISION
WELL PLUGGING APPLICATION**
Please TYPE Form and File ONE Copy

Form CP-1
September 2003
**This Form must be Typed
Form must be Signed
All blanks must be Filled**

API # 15 - NA-009-07024-00-00 (Identifier Number of this well). This must be listed for wells drilled since 1967; if no API # was issued, indicate original spud or completion date 11/10/43

Well Operator: Kirby Krier Oil, Inc. KCC License #: 9951
(Owner/Company Name) (Operator's)

Address: 1043 NE 80th Rd City: Claffin

State: Kansas Zip Code: 67525 Contact Phone: (620) 587-3810

Lease: Martha Case Well #: #1 Sec. 25 Twp. 16 S. R. 12 East West

NE - NE - NW Spot Location / QQQQ County: Barton

330' Feet (in exact footage) From North / South (from nearest outside section corner) Line of Section (Not Lease Line)

2340' 2970' Feet (in exact footage) From East / West (from nearest outside section corner) Line of Section (Not Lease Line)

Check One: Oil Well Gas Well D&A Cathodic Water Supply Well

SWD Docket # _____ ENHR Docket # _____ Other: _____

Conductor Casing Size: _____ Set at: _____ Cemented with: _____ Sacks

Surface Casing Size: 8-5/8" Set at: 425' Cemented with: 210 Sacks

Production Casing Size: 5-1/2" Set at: 3351' Cemented with: 100 Sacks

List (ALL) Perforations and Bridgeplug Sets: OH: 3355'-65';

Elevation: 1919 (G.L. / K.B.) T.D.: 3365' PBTD: _____ Anhydrite Depth: _____
(Stone Corral Formation)

Condition of Well: Good Poor Casing Leak Junk in Hole

Proposed Method of Plugging (attach a separate page if additional space is needed): As per KCC

**RECEIVED
DEC 27 2004
KCC WICHITA**

Is Well Log attached to this application as required? Yes No Is ACO-1 filed? Yes No

If not explain why? Not provided by the operator.

Plugging of this Well will be done in accordance with K.S.A. 55-101 et. seq. and the Rules and Regulations of the State Corporation Commission.

List Name of Company Representative authorized to be in charge of plugging operations: Edward S. Nemnich

Phone: (620) 587-3361

Address: P.O. Box 231 City / State: Claffin, Kansas 67525

Plugging Contractor: D.S.&W. Well Servicing, Inc. KCC License #: 6901

Address: P.O. Box 231, Claffin, Kansas 67525 Phone: (620) 587-3361

Proposed Date and Hour of Plugging (if known?): ASAP

Payment of the Plugging Fee (K.A.R. 82-3-118) will be guaranteed by Operator or Agent

Date: 12/23/24 Authorized Operator / Agent: Edward S. Nemnich
(Signature)

Mail to: KCC - Conservation Division, 130 S. Market - Room 2078, Wichita, Kansas 67202

10/05

6/05

Gulf Oil

1

Martha Case

25-16-12W
NE NE NW


Contr. _____ *Barton* County

E 1919 Comm. *10-10-43* Comp. *11-10-43* IP Pot. 670 bbls. Pump

Tops	Depth	Datum	Casing
Arb.	3350	-1431	8" 420
ID	3365		5" 3351
			Pot. 670 bbls. Pump

RECEIVED
DEC 27 2004
KCC WICHITA

INDEPENDENT OIL & GAS SERVICE
WICHITA, KANSAS

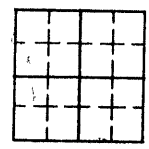


MARTHA M. CASE NO. 1

LOCATION

Center NE NE NW, 2310' east of west line and 330' south of north line of NW/4 Section 25-16S-12W, Barton County, Kansas

Derrick floor elevation 1919'

RECEIVED
DEC 27 2004
KCC WICHITA

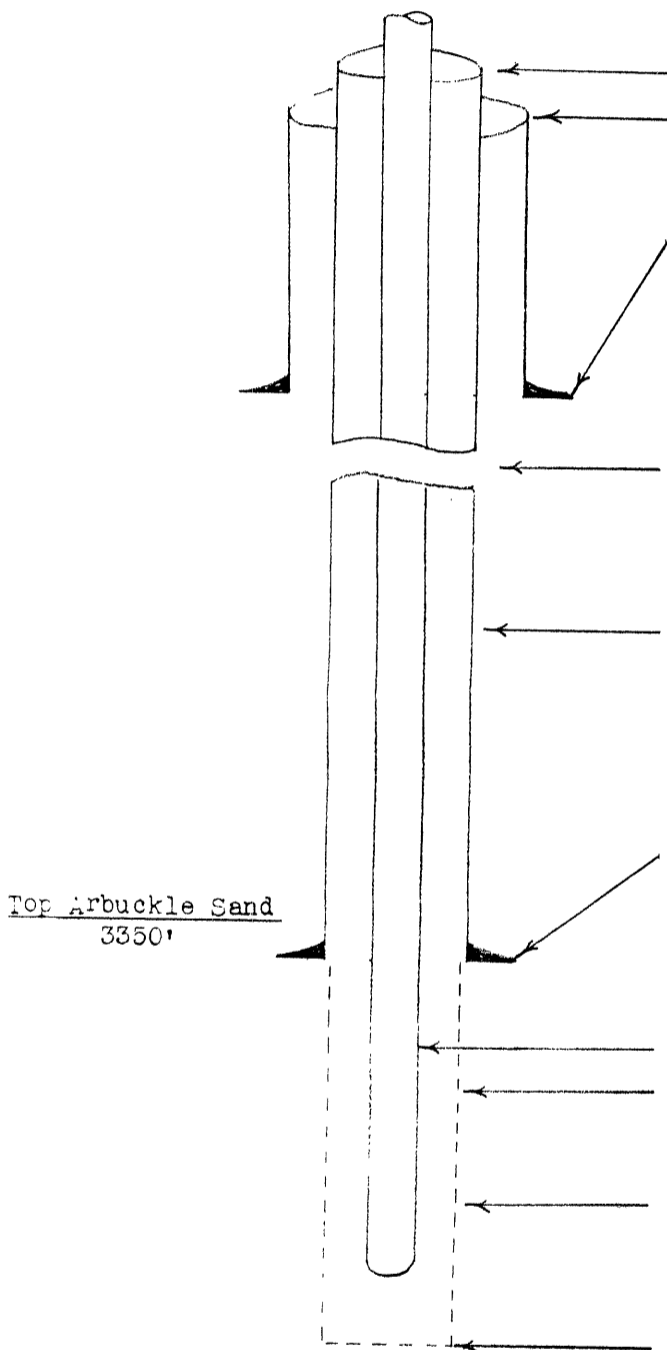

Top collar 7' below rotary table

Top collar 9' below rotary table

19 jt 8-5/8" 32# 10 thd Class C-1 LW casing set at 425'. Tally 411'. Cemented with 210 sacks Red Ring cement and 300# calcium chloride. Plug to 410'. Cement circulated

Top of cement behind 5-1/2" casing 2150'

150 jt 2-7/8" OD 6.50# 8 rd thd Class A EUE SS tubing set at 3363'

108 jt 5-1/2" 14# 8 rd thd SS casing (29 jt Class A, 79 jt Class B) set at 3351'. Tally 3344'. Cemented with 100 sacks Lone Star cement. Plug to 3308'.

Perforations in tubing 3357'

3355-60 Arbuckle sand. Swabbed 58 oil, no water in 6 hr from 1500' off bottom


3360-65 Light gray Arbuckle sand. Static fluid level 2635'

Total Depth 3365'. Not acidized

State Physical Potential: 12-2-43, 655 oil, no water

COPY

Paul G. Bille

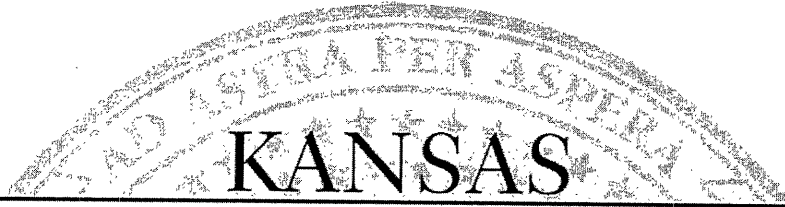

CORPORATION COMMISSION

Kathleen Sebelius, Governor Brian J. Moline, Chair Robert E. Krehbiel, Commissioner Michael C. Moffet, Commissioner

NOTICE OF RECEIPT OF WELL PLUGGING APPLICATION (CP-1)

Krier, Kirby Oil, Inc.
1043 NE 80th Rd.
Claflin, KS 67525

January 03, 2005

Re: CASE MARTHA M #1
API 15-009-07024-00-00
NENENW 25-16S-12W, 330 FNL 2970 FEL
BARTON COUNTY, KANSAS

Dear Operator:

This letter is to notify you that the Conservation Division is in receipt of your plugging proposal, form CP-1, for the above-captioned well.

Your CP-1 has been reviewed by the Conservation Division central office for completeness and to verify license numbers. The plugging proposal will now be forwarded to the district office listed below for review of your proposed method of plugging.

Please contact the district office for approval of your proposed plugging method at least five (5) days before plugging the well, pursuant to K.A.R. 82-3-113 (b). If a workover pit will be used during the plugging of the well it must be permitted. A CDP-1 form must be filed and approved prior to the use of the pit.

The Conservation Division's review of form CP-1, either in the central or district office, does not include an inquiry into well ownership or the filing operator's legal right to plug the well.

This notice in no way constitutes authorization to plug the above-captioned well by persons not having legal rights of ownership or interest in the well. This notice is void after ninety (90) days from the above date.

Sincerely

David P. Williams
Production Supervisor

District: #4
2301 E. 13th
Hays, KS 67601
(785) 625-0550