

STATE CORPORATION COMMISSION OF KANSAS
OIL & GAS CONSERVATION DIVISION
WELL COMPLETION OR RECOMPLETION FORM
ACO-1 WELL HISTORY
DESCRIPTION OF WELL AND LEASE

Operator: License # 5313
Name F & M OIL CO., INC.
Address 422 Union Center
Wichita, Ks. 67202

Purchaser None

Operator Contact Person Ronald S. Schraeder
Phone (316) 262-2636

Contractor: License # 5422
Name Abercrombie Drilling, Inc.

Wellsite Geologist Phil Askey
Phone (316) 262-2636

Designate Type of Completion
 New Well Re-Entry Workover
Oil SWD Temp Abd
Gas Inj Delayed Op
 Dry Other (Core, Water Supply etc.)
If OWNO: old well info as follows:

Operator
Well Name
Comp. Date Old Total Depth

WELL HISTORY

Drilling Method:
 Mud Rotary Air Rotary Cable
5-21-86 5-28-86 5-28-86
Spud Date Date Reached TD Completion Date
3810' None
Total Depth PBDT

Amount of Surface Pipe Set and Cemented at 316 feet
Multiple Stage Cementing Collar Used? Yes No
If yes, show depth set feet
If alternate 2 completion, cement circulated from feet depth to w/SX cmt
Cement Company Name
Invoice #

API NO. 15-
County Norton
NE SE SW 4' 5S 24W East
Sec. Twp. Rge. XX West
990
2970
Ft North from Southeast Corner of Section
Ft West from Southeast Corner of Section
(Note: Locate well in section plat below)


Lease Name Berry "E" Well # 1

Field Name Unkown

Producing Formation None

Elevation: Ground 2309' 2314' KB

Section Plat

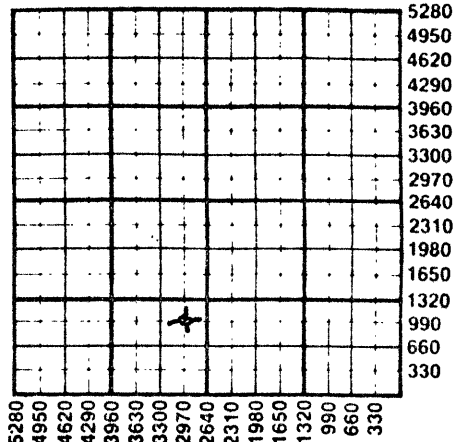

WATER SUPPLY INFORMATION

Disposition of Produced Water: Disposal
Docket # Repressuring

Questions on this portion of the ACO-1 call:

Water Resources Board (913) 296-3717

Source of Water:
Division of Water Resources Permit #

Groundwater Ft North from Southeast Corner (Well) Ft West from Southeast Corner of Sec Twp Rge East West

Surface Water 1090 Ft North from Southeast Corner (Stream, Pond, etc) 2970 Ft West from Southeast Corner Sec 4 Twp 5S Rge 24 East XX West

D. W. Berry
Other (explain) (purchased from city, R.W.D. #)

6-26-86
RECEIVED
STATE CORPORATION COMMISSION
JUN 26 1986
CONSERVATION DIVISION
Wichita, Kansas
TIGHT HOLE


INSTRUCTIONS: This form shall be completed in triplicate and filed with the Kansas Corporation Commission, 200 Colorado Derby Building, Wichita, Kansas 67202, within 120 days of the spud date of any well. Rule 82-3-130, 82-3-107 and 82-3-106 apply. Information on side two of this form will be held confidential for a period of 12 months if requested in writing and submitted with the form. See rule 82-3-107 for confidentiality in excess of 12 months. One copy of all wireline logs and drillers time log shall be attached with this form. Submit CP-4 form with all plugged wells. Submit CP-111 form with all temporarily abandoned wells.

All requirements of the statutes, rules and regulations promulgated to regulate the oil and gas industry have been fully complied with and the statements herein are complete and correct to the best of my knowledge.

Signature Ronald S. Schraeder
Title Operations Manager Date 6-23-86

K.C.C. OFFICE USE ONLY
 Letter of Confidentiality Attached
 Wireline Log Received
 Drillers Timelog Received
Distribution
 KCC SWD/Rep NGPA
 KGS Plug Other
(Specify)

Subscribed and sworn to before me this 23rd day of June 1986
Notary Public Shirley A. Robinson
Date Commission Expires 12-24-88

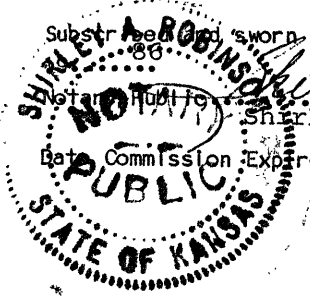

Sec. 11, Twp 5, Rge. 24 W