

CARD MUST BE TYPED

State of Kansas

CARD MUST BE SIGNED

NOTICE OF INTENTION TO DRILL HUGOTON INFILL

EFFECTIVE DATE 1-30-2005

Starting Date 2/1/05 month day year

SGA NO KCCDIST #1

API Number 15 - 175-21965-00-00

OPERATOR: License # 8061 Name Oil Producers, Inc. of Kansas Address P.O. Box 8647 City/State/Zip Wichita, Ks 67208 Contact Person Diana Richecky Phone 316-681-0231

CONTRACTOR: License # 33375 Name Cheyenne Drilling LP City/State Garden City, Ks

Well Drilled as: X New Recompletion OWWO Projected Total Depth 2800 feet Formation chase

If OWWO or Recompletion: old well info as follows: Operator Well Name Comp. Date Old Total Depth

I certify that well will comply with K.S.A. 55-101, et seq., plus eventually plugging hole to KCC specifications.

Date 1/24/05 Signature of Operator or Agent Diana Richecky Title Land Administrator

IS SECTION REGULAR IRREGULAR Ap SE SE NW NE Sec. 2 Twp. 32 S Rg. 33 W 1250 Ft. from South Line of Section 1450 Ft. from East Line of Section

NOTE: Attach acreage attribution plat locating both Chase (Hugoton) wells Total number of acres attributed to unit 640

Nearest producing well from same common source of supply 1780 feet

Nearest lease or unit boundary line 1250 feet County Seward

Lease Name Lemert Well # 2-2 Ground surface elevation 2871 feet MSL

Depth to bottom of fresh water 550 Depth to bottom of usable water 580

Surface pipe by Alternate: Surface pipe planned to be set 1800 feet

Water Source for Drilled Operations: DWR Permit #: well farm pond X other

For KCC Use:

Conductor Pipe Required NONE feet; Minimum Surface Pipe Required 600' MIN feet per Alt. 1 This Authorization Expires 7-25-2005 Approved By KSP 1-25-2005

9/95


RECEIVED KANSAS CORPORATION COMMISSION

JAN 25 2005

CONSERVATION DIVISION WICHITA, KS

Must be filed with K.C.C. five (5) days prior to commencing well This card void if drilling not started within six (6) months of date received by K.C.C.

A Regular Section of Land, 1 Mile = 5,280 Ft.

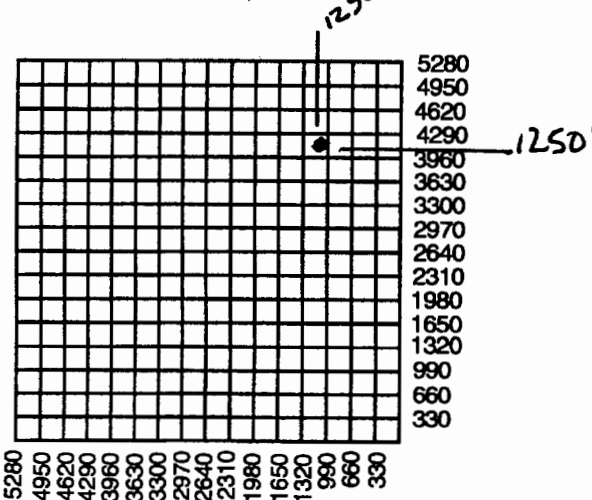

Important procedures to follow:

- 1. Notify District office before setting surface casing.
2. Set surface casing by circulating cement to the top.
3. File completion forms ACO-1 with K.C.C. within 120 days of well spud date, following instructions on ACO-1, side 1, and including copies of wireline logs.
4. Notify District office 48 hours prior to old well workover or re-entry.
5. Submit plugging report (CP-4) to K.C.C. after plugging is completed.
6. If an alternate 2 completion, cement in the production pipe from below any useable water to surface within 120 days of spud date.

Handwritten vertical notes: 12, 32, 33, 3

State Corporation Commission of Kansas Conservation Division 130 S. Market Room 2078 Wichita, Kansas 67202-1212 (316) 337-6231