

For KCC Use:

Effective Date: 1-23-2005

District # 1

SGA?  Yes  No

### NOTICE OF INTENT TO DRILL

Must be approved by KCC five (5) days prior to commencing well

Form must be Typed  
Form must be Signed  
All blanks must be Filled

Expected Spud Date APR 6 2005  
month day year

OPERATOR: License # 04824 (2-28-2005)  
Name: PIONEER NATURAL RESOURCES USA, INC.  
Address: 5205 N. O'CONNOR BLVD. - ROOM 1325  
City/State/Zip: IRVING, TEXAS 75039  
Contact Person: LINDA KELLY  
Phone: 972-969-3946

CONTRACTOR: License #: WILL ADVISE ON ACO-1  
Name: MUST BE LICENSED W/ KCC RSP/KCC

|                                                              |                                   |                                                |
|--------------------------------------------------------------|-----------------------------------|------------------------------------------------|
| Well Drilled For:                                            | Well Class:                       | Type Equipment:                                |
| <input type="checkbox"/> Oil                                 | <input type="checkbox"/> Enh Rec  | <input checked="" type="checkbox"/> Infield    |
| <input checked="" type="checkbox"/> Gas                      | <input type="checkbox"/> Storage  | <input checked="" type="checkbox"/> Mud Rotary |
| <input type="checkbox"/> OWWO                                | <input type="checkbox"/> Disposal | <input type="checkbox"/> Pool Ext.             |
| <input type="checkbox"/> Seismic; # of Holes                 | <input type="checkbox"/> Wildcat  | <input type="checkbox"/> Air Rotary            |
| <input checked="" type="checkbox"/> Other <u>REPLACEMENT</u> | <input type="checkbox"/> Other    | <input type="checkbox"/> Cable                 |

If OWWO: old well information as follows:

Operator: \_\_\_\_\_  
Well Name: \_\_\_\_\_  
Original Completion Date: \_\_\_\_\_ Original Total Depth \_\_\_\_\_

Directional, Deviated or Horizontal well?  Yes  No

If yes, true vertical depth: \_\_\_\_\_

Bottom Hole Location JAN 14 2005

KCC DKT # \_\_\_\_\_

## KCC WICHITA

Spot NE NE/4 SW/4 SW/4 Sec 22 Twp 30 S. R. 38W  East  West

1250 feet from  N/S  Line of Section  
1250 feet from  E/W  Line of Section

Is SECTION  Regular  Irregular?

(Note: Locate well on Section Plat on Reverse Side)

County: GRANT

Lease Name: SCHMIDT Well #: 3-22R

Field Name: HUGOTON

Is this a Prorated/Spaced Field?  Yes  No

Target Formation(s): CHASE

Nearest Lease or unit boundary: 1250

Ground Surface Elevation: 3138 feet MSL

Water well within one-quarter mile:  yes  no

Public water supply within one mile:  yes  no

Depth to bottom of fresh water: 400'

Depth to bottom of usable water: 580'

Surface Pipe by Alternate:  1  2

Length of Surface Pipe Planned to be set: 600' MIN

Length of Conductor pipe required: NONE

Projected Total Depth: 3200' explor only/PBD 2950'

Formation at Total Depth: CHASE

Water Source for Drilling Operations:

Well  Farm Pond  Other

DWR Permit #: \_\_\_\_\_

(Note: Apply for Permit with DWR )

Will Cores Be Taken?:  Yes  No

If yes, proposed zone: \_\_\_\_\_

### AFFIDAVIT

The undersigned hereby affirms that the drilling, completion and eventual plugging of this well will comply with K.S.A. 55- 101 et, seq. It is agreed that the following minimum requirements will be met:

1. Notify the appropriate district office **prior** to spudding of well;
2. A copy of the approved notice of intent to drill **shall be** posted on each drilling rig;
3. The minimum amount of surface pipe as specified below **shall be set** by circulating cement to the top; in all cases surface pipe **shall be set** through all unconsolidated materials plus a minimum of 20 feet into the underlying formation;
4. If the well is dry hole, an agreement between the operator and the district office on plug length and placement is **necessary prior to plugging**;
5. The appropriate district office will be notified before well is either plugged or production casing is cemented in;
6. If an ALTERNATE II COMPLETION, production pipe shall be cemented from below any usable water to surface within **120 days** of spud date. Or pursuant to Appendix "B" - Eastern Kansas surface casing order #133,891-C, which applies to the KCC District 3 area, alternate II cementing must be completed within 30 days of the spud date or the well shall be plugged. **In all cases, NOTIFY district office** prior to any cementing.

I hereby certify that the statements made herein are true and to the best of my knowledge and belief.

Date: January 10, 2005 Signature of Operator or Agent: Linda Kelly Title: ENGINEERING TECH

**For KCC Use ONLY**  
 API # 15- 067-21601-00-00  
 Conductor pipe required NONE feet  
 Minimum surface pipe required 600 feet per Alt (1)  
 Approved by: RSP-1-18-2005  
 This authorization expires: 7-18-2005  
 (This authorization void if drilling not started within 6 months of effective date.)  
 Spud date: \_\_\_\_\_ Agent \_\_\_\_\_

#### Remember to:

- File Drill Pit Application (form CDP-1) with Intent to Drill;
- File Completion Form ACO-1 within 120 days of spud date;
- File acreage attribution plat according to field proration orders;
- Notify appropriate district office 48 hours prior to workover or re-entry;
- Submit plugging report (CP-4) after plugging is completed;
- Obtain written approval before disposing or injecting salt water.
- If permit has expired (See: authorized expiration date) please check the box below and return to the address below

Well Not Drilled - Permit Expired

Signature of Operator or Agent: \_\_\_\_\_

Date: \_\_\_\_\_

22  
30  
380

**IN ALL CASES PLOT THE INTENDED WELL ON THE PLAT BELOW**

*Plat of acreage attributable to a well in a prorated or spaced field*

*If the intended well is in a prorated or spaced field, please fully complete this side of the form. If the intended well is in a prorated or spaced field complete the plat below showing that the well will be properly located in relationship to other wells producing from the common source of supply. Please show all the wells within 1 mile of the boundaries of the proposed acreage attribution unit for gas wells and within 1/2 mile of the boundaries of the proposed acreage attribution unit for oil wells.*

API No. 15- 067-21601-00-00  
 Operator PIONEER NATURAL RESOURCES  
 Lease SCHMIDT  
 Well Number 3-22R  
 Field HUGOTON


Location of Well: County: GRANT  
1250 feet from  N / S  Line of Section  
1250 feet from  E / W  Line of Section.  
 Sec 22 Twp 30 S. R. 38W  East  West

Number of Acres attributable to well: 640  
 QTR/QTR/QTR of acreage: NE/4 - SW/4 - SW/4


Is Section  Regular or  Irregular  
**If Section is irregular, locate well from nearest corner boundary.**  
 Section corner used:  NE  NW  SE  SW

**PLAT**

*(Show location of the well and shade attributable acreage for prorated or spaced wells.)  
 (Show footage to nearest lease or unit boundary line)*

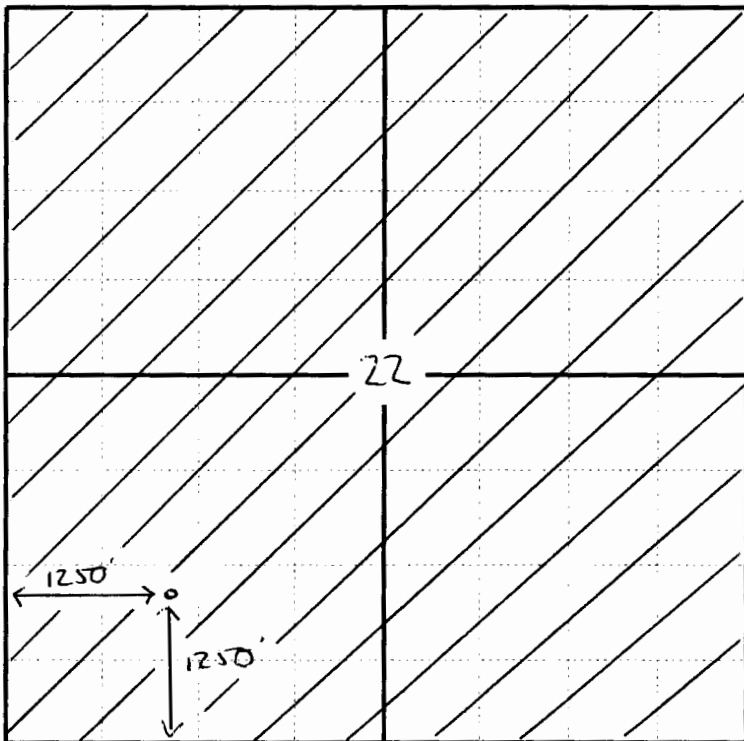

GRANT CO.

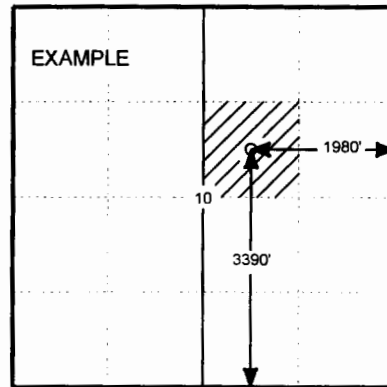

SEWARD CO.

**In plotting the proposed location of the well, you must show;**

1. The manner in which you are using the depicted plat by identifying section lines, i.e. 1 section, 1 section with 8 surrounding sections, 4 sections, etc.;
2. The distance of the proposed drilling location from the section's south/north and east/west; and 3.
3. The distance to the nearest lease or unit boundary line.
4. If proposed location is located within a prorated or spaced field a certificate of acreage attribution plat must be attached: (CO-7 for oil wells; CG-8 for gas wells).