

CORRECTED ~~FIRST~~ ~~SECOND~~

CARD MUST BE TYPED

State of Kansas

CARD MUST BE SIGNED

NOTICE OF INTENTION TO DRILL
HUGOTON INFILL

EFFECTIVE DATE 12-12-04

Starting Date 2 16 05
month day year

API Number 15 - 081.21562.00-00

OPERATOR: License # 04782 (1-30-06)
Name Medicine Bow Operating Company
Address 1225 17th Street, Suite 1900
City/State/Zip Denver, Colorado 80202
Contact Person Julie L. Acevedo
Phone 303-675-4428

IS SECTION X REGULAR IRREGULAR
C NW Sec 28 Twp 30 S, Rg 32 W
1,320 FNL Ft. from South Line of Section
1,320 FWL Ft. from East Line of Section

* CONTRACTOR: License # 33545 (2-2804)
Name Pioneer Drilling Services
City/State Denver, Colorado
Well Drilled as X New Recompletion OWWO
Projected Total Depth 3,250 feet
Formation -1811502326

NOTE: Attach acreage attribution plat locating both Chase (Hugoton) wells
Total number of acres attributed to unit 640
Nearest producing well from
same common source of supply 1,875'
Nearest lease or unit boundary line 1,320 feet
County Haskell
Lease Name Avery Well # 2-28
Ground surface elevation 2,875.7 feet MSL
Depth to bottom of fresh water 600'
Depth to bottom of usable water 620'
Surface pipe by Alternate: 1 X 2
Surface pipe planned to be set 8 5/8" set @ 650'
Water Source for Drilled Operations:
DWR Permit #: X well farm pond other

If OWWO or Recompletion: old well info as follows:
Operator
Well Name
Comp. Date Old Total Depth


I certify that well will comply with K.S.A. 55-101, et seq., plus eventually plugging hole to KCC specifications.
Date 2-10-05 Signature of Operator or Agent [Signature] Title HSE Mgr.

For KCC Use:
Conductor Pipe Required NONE feet; Minimum Surface Pipe Required 640 feet per Alt D
This Authorization Expires 6-7-05 Approved By RJP 12.7.04 / RJP 2.17.05 / RJP 2.18.05
9/95

Must be filed with K.C.C. five (5) days prior to commencing well
This card void if drilling not started within six (6) months of date received by K.C.C.

Note: 2.17.05
CORRECTION
SHOW LOCATION
REFERENCED
TO SE CORNER
SHOULD BE
REF. TO NW CORNER

A Regular Section of Land
1 Mile = 5,280 Ft.

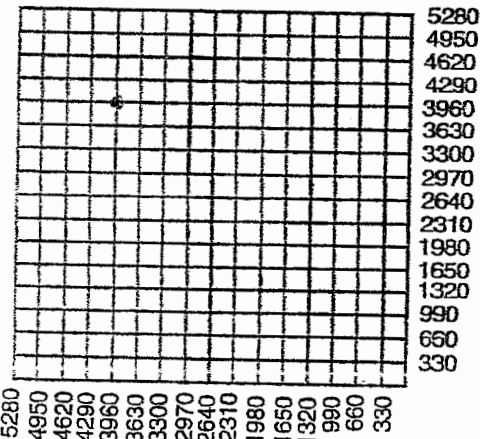

- Important procedures to follow:
1. Notify District office before setting surface casing.
 2. Set surface casing by circulating cement to the top.
 3. File completion forms ACO-1 with K.C.C. within 120 days of well spud date, following instructions on ACO-1, side 1, and including copies of wireline logs.
 4. Notify District office 48 hours prior to old well workover or re-entry.
 5. Submit plugging report (CP-4) to K.C.C. after plugging is completed.
 6. If an alternate 2 completion, cement in the production pipe from below any useable water to surface within 120 days of spud date.

State Corporation Commission of Kansas
Conservation Division
130 S. Market Room 2078
Wichita, Kansas 67202-1212
(316) 337-6231

* Drilling Contractor was: Allen Drilling # 4782
IS: Pioneer Drilling Services # 33545

RECEIVED
FEB 14 2005
KCC WICHITA