


15-137-00063-00-00

WELL PLUGGING RECORD

Give All Information Completely
Make Required Affidavit
Mail or Deliver Report to:
Conservation Division
State Corporation Commission
800 Biting Building
Wichita, Kansas

NORTH

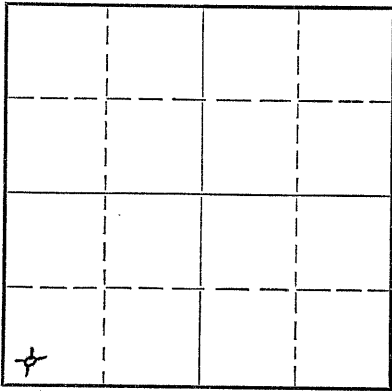

Locate well correctly on above Section Plat

Norton County. Sec. 11 Twp. 5S Rge. 24W (E) (W)
Location as "NE/CNW $\frac{1}{4}$ SW $\frac{1}{4}$ " or footage from lines SW SW SW
Lease Owner Peel-Hardman
Lease Name Allen Well No. 1
Office Address P. O. Box 359, Hoisington, Kansas
Character of Well (completed as Oil, Gas or Dry Hole) Dry Hole
Date well completed June 16 19 51
Application for plugging filed July 15 19 51
Application for plugging approved July 15 19 51
Plugging commenced July 15 19 51
Plugging completed August 7 19 51
Reason for abandonment of well or producing formation Dry Hole

If a producing well is abandoned, date of last production 19...
Was permission obtained from the Conservation Division or its agents before plugging was commenced? Yes

Name of Conservation Agent who supervised plugging of this well Eldon Petty
Producing formation Depth to top Bottom Total Depth of Well 3835 Feet
Show depth and thickness of all water, oil and gas formations.

OIL, GAS OR WATER RECORDS

CASING RECORD

Formation	Content	From	To	Size	Put In	Pulled Out
		0	173'	8 5/8"	173'	None
		0	3597'	5 1/2"	3597'	2933'

Describe in detail the manner in which the well was plugged, indicating where the mud fluid was placed and the method or methods used in introducing it into the hole. If cement or other plugs were used, state the character of same and depth placed, from feet to feet for each plug set.

Original total depth 3835' plugged back to 3441'
3441' - 3409' - 4 sacks cement
3409' - 174 1/2' - Heavy Rotary Mud
174 1/2' - 173' - Rock Bridge
173' - 127' - 15 sacks cement
127' - 36 1/2' - Heavy Rotary Mud
36 1/2' - 35' - Rock Bridge
35' - 6' - 10 sacks cement
6' - Surface - Cellar

(If additional description is necessary, use BACK of this sheet)
Name of Plugging Contractor Peel-Hardman
Address P. O. Box 359, Hoisington, Kansas

STATE OF Kansas, COUNTY OF Barton, ss.
Peel-Hardman (Employee of owner or (owner or operator) of the above-described well,

being first duly sworn on oath, says: That I have knowledge of the facts, statements, and matters herein contained and the log of the above-described well as filed and that the same are true and correct. So help me God.

BY: *Wm. Herper*
(Signature) PEEL-HARDMAN, INC., P.O., ETC.
P. O. Box 359
Hoisington, Kansas (Address)

SUBSCRIBED AND SWORN TO before me this 10th day of August, 19 51

My commission expires June 4, 1955
Notary Public.

23-8390-s
PLUGGING
FILE SEC 11 T 5 R 24 W
BOOK PAGE 107 LINE 34

RECEIVED
STATE CORPORATION COMMISSION
AUG 14 1951
CONSERVATION DIVISION
Wichita, Kansas

8-14-51