


STATE OF KANSAS
STATE CORPORATION COMMISSION

Give All Information Completely
Make Required Affidavit
Mail or Deliver Report to:
Conservation Division
State Corporation Commission
800 Biting Building
Wichita, Kansas

15-137-00183-00-00
WELL PLUGGING RECORD

NORTH

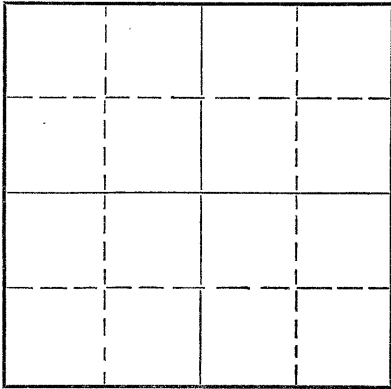

Locate well correctly on above
Section Plat

Norton County. Sec 16 Twp. 5 Rge. 24 (E) (W)
Location as "NE/CNW/SW" or footage from lines 330 ft. S. 330 Ft. W.
Lease Owner Arthur Scheetz
Lease Name Barbo Well No. 1
Office Address Denver, Colo
Character of Well (completed as Oil, Gas or Dry Hole) dry hole
Date well completed 3-7 1955
Application for plugging filed 3-7 1955
Application for plugging approved 3-7 1955
Plugging commenced 3-7 1955
Plugging completed 3-7 1955
Reason for abandonment of well or producing formation dry hole

If a producing well is abandoned, date of last production 19
Was permission obtained from the Conservation Division or its agents before plugging was commenced? yes

Name of Conservation Agent who supervised plugging of this well Eldon Petty
Producing formation Depth to top Bottom Total Depth of Well 3925 Feet
Show depth and thickness of all water, oil and gas formations.

OIL, GAS OR WATER RECORDS

CASING RECORD

FORMATION	CONTENT	FROM	TO	SIZE	PUT IN	PULLED OUT

Describe in detail the manner in which the well was plugged, indicating where the mud fluid was placed and the method or methods used in introducing it into the hole. If cement or other plugs were used, state the character of same and depth placed, from 160 feet to 40 feet for each plug set.

Filled the hole with heavy mud on the bottom pulled pipe to 1500 feet and circulated with heavy mud. Pulled pipe and set plug at 160 feet mixed 15 sx cement and 1/2 sx hulls through drill pipe and filled with mud to 40 feet with 10 sx cement and 1/2 sx hulls set 2nd plug filled surface casing to bottom of cellar.

RECEIVED
STATE CORPORATION COMMISSION
MAY 12 1955
CONSERVATION DIVISION
WICHITA, KANSAS
3-12-55

(If additional description is necessary, use BACK of this sheet)
Name of Plugging Contractor Sauvage-Dunn Drilling Co., Inc.
Address Oberlin, Kansas

STATE OF Kansas, COUNTY OF Decatur, ss.
(employee of owner) or (owner or operator) of the above-described well, being first duly sworn on oath, says: That I have knowledge of the facts, statements, and matters herein contained and the log of the above-described well as filed and that the same are true and correct. So help me God.

(Signature) [Signature]
(Address)

SUBSCRIBED AND SWORN TO before me this 11th day of March, 1955

My commission expires May 17, 1955
Opal Sauvage
Notary Public.

24-7368-S 3-53-20M

PLUGGING
FILE SEC 16 T 5 R 24W
BOOK PAGE 103 LINE 23