


15-137-00710-00-00

STATE OF KANSAS
STATE CORPORATION COMMISSION
CONSERVATION DIVISION
P. O. BOX 17027
WICHITA, KANSAS 67217

FORM CP-4

WELL PLUGGING RECORD

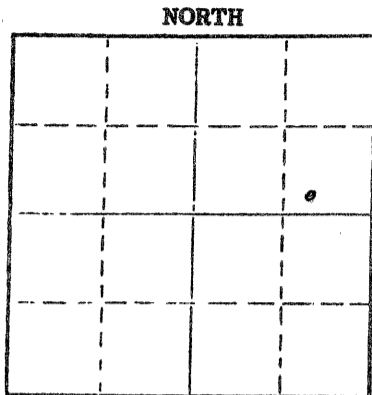

Locate well correctly on above Section Plat

Norton County, Sec. 23 Twp. 5 Rge. 21 W (E) 31 (W)
Location as "NE/CNW&SW¼" or footage from lines SW SE NE
Lease Owner Raymond M. Goodin
Lease Name Baird "A"
Office Address 209 Brown Building, Wichita, Kansas 67202 Well No. 2
Character of Well (completed as Oil, Gas or Dry Hole) oil
Date well completed Dec. 28 19 57
Application for plugging filed Dec. 22 19 75
Application for plugging approved 19
Plugging commenced Jan. 12 19 76
Plugging completed Jan. 15 19 76
Reason for abandonment of well or producing formation depleted

If a producing well is abandoned, date of last production 19
Was permission obtained from the Conservation Division or its agents before plugging was commenced? yes

Name of Conservation Agent who supervised plugging of this well Gilbert Balthazor
Producing formation Depth to top Bottom Total Depth of Well 3617 Feet
Show depth and thickness of all water, oil and gas formations.

OIL, GAS OR WATER RECORDS

CASING RECORD

FORMATION	CONTENT	FROM	TO	SIZE	PUT IN	PULLED OUT
			239'	8 5/8"	239'	none
			3612'	5 1/2"	3612'	980.72

Describe in detail the manner in which the well was plugged, indicating where the mud fluid was placed and the method or methods used in introducing it into the hole. If cement or other plugs were used, state the character of same and depth placed, from feet to feet for each plug set.

Sanded back to 3340' and dumped 5 sacks of cement.
Allied Cementing Company plugged well pumping in 3 sacks of hulls, 14 sacks of gel and 130 sacks of cement.

Name of Plugging Contractor PIPE PULLERS, INC. (If additional description is necessary, use BACK of this sheet)
Address Box 128, Ellinwood, Kansas 67526

STATE OF KANSAS COUNTY OF BARTON ss.
Evelyn Roth

(employee of owner) or (owner or operator) of the above-described well, being first duly sworn on oath, says: That I have knowledge of the facts, statements, and matters herein contained and the log of the above-described well as filed and that the same are true and correct. So help me God.

(Signature) Evelyn Roth
Ellinwood, Kansas (Address)

SUBSCRIBED AND SWORN TO before me this 20th day of January, 1976

My commission expires
JENNY KASSELMAN,
NOTARY PUBLIC
BARTON COUNTY, KANSAS
MY COMM. EXP. JULY 16, 1978

Jerry Kasselmann
Notary Public.

RECEIVED
STATE CORPORATION COMMISSION
JAN 21 1976
CONSERVATION DIVISION
Wichita, Kansas