


STATE OF KANSAS
STATE CORPORATION COMMISSION

Give All Information Completely
Make Required Affidavit
Mail or Deliver Report to:
Conservation Division
State Corporation Commission
211 No. Broadway
Wichita, Kansas

15-137-00160-00-00

WELL PLUGGING RECORD

NORTH

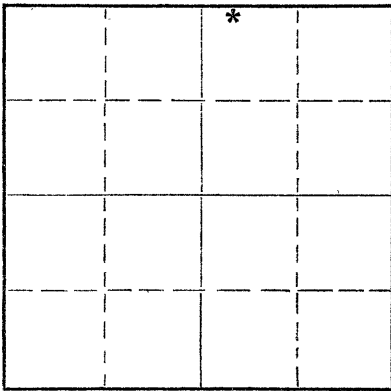

Locate well correctly on above
Section Plat

Norton

County. Sec. 34 Twp. 5S Rge. 21W (E) (W)

Location as "NE/CNW $\frac{1}{2}$ SW $\frac{1}{4}$ " or footage from lines NW NW NE

Lease Owner. Jocelyn-Varn Oil Company

Lease Name. Jacobson

Well No. 1

Office Address. 310 KFH Bldg, Wichita, Kansas

Character of Well (completed as Oil, Gas or Dry Hole) oil

Date well completed. January 15 19 58

Application for plugging filed. May 19 59

Application for plugging approved. 19

Plugging commenced. June 1 19 59

Plugging completed. June 4 19 59

Reason for abandonment of well or producing formation. non-commercial

If a producing well is abandoned, date of last production April 19 59

Was permission obtained from the Conservation Division or its agents before plugging was commenced? yes

Name of Conservation Agent who supervised plugging of this well. A. D Fabricius

Producing formation. Lansing Kansas City Depth to top. 3445' Bottom. 3682' Total Depth of Well. 3702' Feet

Show depth and thickness of all water, oil and gas formations.

OIL, GAS OR WATER RECORDS

CASING RECORD

FORMATION	CONTENT	FROM	TO	SIZE	PUT IN	PULLED OUT
				8 5/8"	235'	none
				5 1/2@	3683'	2209'

Describe in detail the manner in which the well was plugged, indicating where the mud fluid was placed and the method or methods used in introducing it into the hole. If cement or other plugs were used, state the character of same and depth placed, from feet to feet for each plug set.

Filled with sand from TD to 3370'. Dumped 3 sacks of cement with dump bailer. Shot off and pulled 2209' casing. Filled with heavy mud to 235' or bottom of surface casing. Set plug @ 235' with 10' of rock for bridge and 3 sacks of cal-seal with 25 sacks of cement for plug from 235' to 145'. Filled casing with heavy mud from 145 to 40'. Set plug at 40' with 10 rock for bridge and 10 sacks of cement for plug from 40 to surface.

RECEIVED
STATE CORPORATION COMMISSION
08-07-1959
AUG 7 1959

CONSERVATION DIVISION
Wichita, Kansas

(If additional description is necessary, use BACK of this sheet)

Name of Plugging Contractor. Southwest Casing Pullingco. Inc.

Address. P.O. Box 364, Great Bend, Kans.

STATE OF KANSAS, COUNTY OF SEDGWICK, ss.
Otis E. Anderson

(employee of owner) or (owner or operator) of the above-described well, being first duly sworn on oath, says: That I have knowledge of the facts, statements, and matters herein contained and the log of the above-described well as filed and that the same are true and correct. So help me God.

(Signature) Otis E. Anderson

310 KFH Bldg, Wichita, Kansas

(Address)

SUBSCRIBED AND SWORN TO before me this 6th day of August, 1959

Doris Anne Selman

Notary Public.

My commission expires November 21, 1962



PLUGGING
FILE SEC 34 T 5 R 21W
BOOK PAGE 58 LINE 39