


Give All Information Completely
Make Required Affidavit
Mail or Deliver Report to:
Conservation Division
State Corporation Commission
800 Bitting Building
Wichita, Kansas

WELL PLUGGING RECORD

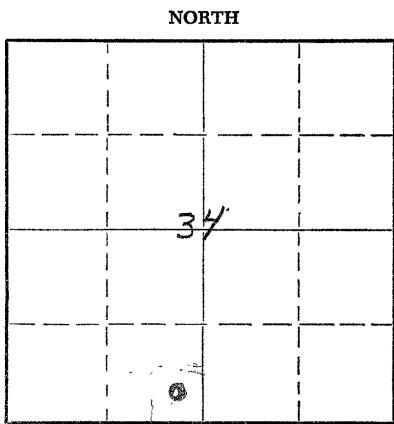

Locate well correctly on above Section Plat

Norton County. Sec. 34 Twp. 5S Rge. 2E (E) 21 (W)
Location as "NE/CNW/SW" or footage from lines SE SE SW
Lease Owner Saturn Drilling, Inc.
Lease Name Sullivan Well No. 1
Office Address 102 Insurance Bldg., Wichita, Kansas
Character of Well (completed as Oil, Gas or Dry Hole) Dry hole
Date well completed May 23 19 52
Application for plugging filed 19
Application for plugging approved 19
Plugging commenced May 25 19 52
Plugging completed May 25 19 52
Reason for abandonment of well or producing formation Dry hole

If a producing well is abandoned, date of last production 19
Was permission obtained from the Conservation Division or its agents before plugging was commenced? Yes

Name of Conservation Agent who supervised plugging of this well Eldon Petty
Producing formation _____ Depth to top _____ Bottom _____ Total Depth of Well 3697 Feet
Show depth and thickness of all water, oil and gas formations.

OIL, GAS OR WATER RECORDS

CASING RECORD

FORMATION	CONTENT	FROM	TO	SIZE	PUT IN	PULLED OUT

Describe in detail the manner in which the well was plugged, indicating where the mud fluid was placed and the method or methods used in introducing it into the hole. If cement or other plugs were used, state the character of same and depth placed, from _____ feet to _____ feet for each plug set.

Drilling mud to 190'. Wooden plug placed at 190' and 15 sacks of cement mixed and put on top of plug through drill pipe. Hole filled with mud to 35' and wooden plug placed at 35'. Small quantity of cotton seed hulls placed on plug and remainder of hole filled with 10 sacks of mixed cement

RECEIVED
STATE CORPORATION COMMISSION
JUN 14 1952
06-14-1952
CONSERVATION DIVISION
Wichita, Kansas

(If additional description is necessary, use BACK of this sheet)

Name of Plugging Contractor _____
Address _____

STATE OF Kansas, COUNTY OF Sedgwick, ss.
John W. McKnab (employee of owner) or (owner or operator) of the above-described well, being first duly sworn on oath, says: That I have knowledge of the facts, statements, and matters herein contained and the log of the above-described well as filed and that the same are true and correct. So help me God.

(Signature) John W. McKnab
102 Insurance Bldg., Wichita, Kansas
(Address)

SUBSCRIBED AND SWORN TO before me this 13th day of June, 1952

Patricia Ann Williams
Notary Public.

My commission expires Jan. 14, 1956

24-2675-S 2-52-20M
PLUGGING
FILE SEC 34 T 5 R 21
BOOK PAGE 19 LINE 17