

15-137-00015-00-00
WELL PLUGGING RECORD


STATE OF KANSAS
STATE CORPORATION COMMISSION

Give All Information Completely
Make Required Affidavit
Mail or Deliver Report to:
Conservation Division
State Corporation Commission
800 Bittig Building
Wichita, Kansas

OR
FORMATION PLUGGING RECORD

Strike out upper line
when reporting plug-
ging off formations.

NORTH

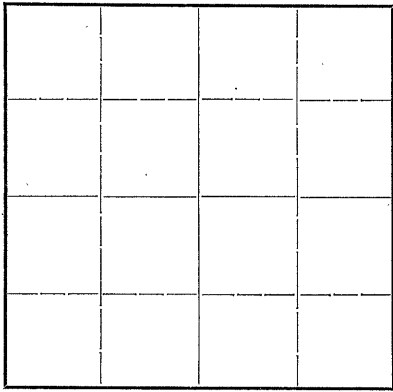

Locate well correctly on above
Section Plat

Norton County. Sec. 34 Twp. 5 Rge. (E) 21 (W)
Location as "NE $\frac{1}{4}$ NW $\frac{1}{4}$ SW $\frac{1}{4}$ " or footage from lines. 330' N 330' E of west $\frac{1}{4}$ corner
Lease Owner. Cities Service Oil Company
Lease Name. Muir Well No. 1
Office Address Bartlesville, Oklahoma.
Character of Well (completed as Oil, Gas or Dry Hole) Dry Hole
Date well completed. 12-23-41 19
Application for plugging filed. 12-30-41 19
Application for plugging approved. 12-30-41 19
Plugging commenced. 12-30-41 19
Plugging completed. 12-30-41 19
Reason for abandonment of well or producing formation
If a producing well is abandoned, date of last production. 19
Was permission obtained from the Conservation Division or its agents before plugging was com-
menced? Yes

Name of Conservation Agent who supervised plugging of this well. Mr. G.T. Alexander
Producing formation. Arbuckle Lime Depth to top. 3697' Bottom. Total Depth of Well. 3788' Feet
Show depth and thickness of all water, oil and gas formations.

OIL, GAS OR WATER RECORDS

CASING RECORD

Formation	Content	From	To	Size	Put In	Pulled Out
<u>Arbuckle Lime</u>	<u>Dry</u>			<u>85/8"</u>	<u>212'</u>	<u>None</u>

Describe in detail the manner in which the well was plugged, indicating where the mud fluid was placed and the method or methods used in introducing it into the hole. If cement or other plugs were used, state the character of same and depth placed, from feet to feet for each plug set.

Filled with mud from 3788' to 212' dumped 12 sacks cement, mud to 30' set plug dumped 10 sacks cement mud and dirt to surface.

(If additional description is necessary, use BACK of this sheet)

Correspondence regarding this well should be addressed to. Mr. R.C. Hauber
Address. Cities Service Oil Co. Great Bend, Kansas

STATE OF Kansas, COUNTY OF Russell, ss.

Mr. J.A. Cleverley (employee of owner) or (owner or operator) of the above-described well, being first duly sworn on oath, says: That I have knowledge of the facts, statements, and matters herein contained and the log of the above-described well as filed and that the same are true and correct. So help me God.

(Signature)

Cities Service Oil Co. Russell, Kansas

SUBSCRIBED AND SWORN TO before me this 8 day of January, 1942.

R.J. Turner
Notary Public.

My commission expires Jan. 26, 1942

