


STATE OF KANSAS
STATE CORPORATION COMMISSION

15-039-20304-00-00

WELL PLUGGING RECORD

Give All Information Completely
Make Required Affidavit
Mail or Deliver Report to
Conservation Division
State Corporation Comm.
245 North Water
Wichita, KS 67202

Decatur County, Sec. 6 Twp. 5S Rge. 26W E/W
Location as "NE/CNW $\frac{1}{4}$ SW $\frac{1}{4}$ " or footage from lines NW SE NW

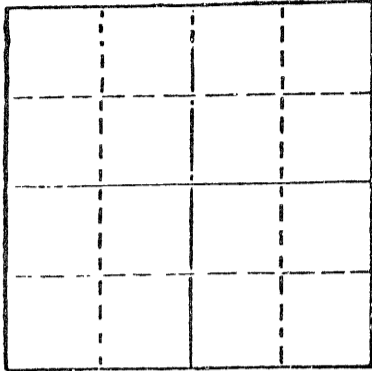

Locate well correctly on above
Section Plat

Lease Owner Frontier Oil Company
Lease Name Nauer Well No. 1
Office Address 1720 Kansas State Bank Building,
Wichita, Kansas
Character of Well (Completed as Oil, Gas or Dry Hole)
Dry Hole

Date Well completed 1-4- 1977
Application for plugging filed 7-27- 1977
Application for plugging approved 6-16- 1977
Plugging commenced 6-10 1977
Plugging completed 6-10 1977

Reason for abandonment of well or producing formation
D&A

If a producing well is abandoned, date of last production
19

Was permission obtained from the Conservation Division or
its agents before plugging was commenced? Yes

Name of Conservation Agent who supervised plugging of this well Gilbert Balthazor
Producing formation LKC Depth to top 3549 Bottom 3740 Total Depth of Well
Show depth and thickness of all water, oil and gas formations.

OIL, GAS OR WATER RECORDS

CASING RECORD

FORMATION	CONTENT	FROM	TO	SIZE	PUT IN	PULLED OUT
				8 5/8	280	-0-

Describe in detail the manner in which the well was plugged, indicating where the mud fluid
was placed and the method or methods used in introducing it into the hold. If cement or other
plugs were used, state the character of same and depth placed, from _____ feet to
_____ feet for each plug set.

Pumped down 8-5/8": 3 sx hulls, 70 sx com., 15 sx gel
Released plug: Added 60 sx 50-50 poz., 6% gel

RECEIVED
AUG 01 1977
CONSERVATION DIVISION
WICHITA, KANSAS

8-1-77

(If additional description is necessary, use BACK of this sheet)

Name of Plugging Contractor Allied Cementing Company

STATE OF KANSAS COUNTY OF SEDGWICK, ss.
Maxine V. Starr (employee of owner) or (owner or operator)
of the above-described well, being first duly sworn on oath, says: That I have knowledge of
the facts, statements, and matters herein contained and the log of the above-described well
as filed and that the same are true and correct. So help me God.

(Signature) Maxine V. Starr

1720 Kansas State Bank Building, Wichita
(Address) Kansas

SUBSCRIBED AND SWORN TO before me this 27th day of July, 1977

D. Ann Drennan
Notary Public.

My commission expires _____

