


STATE OF KANSAS
STATE CORPORATION COMMISSION

WELL PLUGGING RECORD

Give All Information Completely
Make Required Affidavit
Mail or Deliver Report to
Conservation Division
State Corporation Comm.
245 North Water
Wichita, KS 67202

DECATUR County. Sec. 28 Twp. 5 Rge. 26 W
Location as "NE/CNW $\frac{1}{4}$ SW $\frac{1}{4}$ " or footage from lines
NW SE NE
Lease Owner C-G DRILLING CO
Lease Name RANDOLPH Well No. 1
Office Address 1107 Douglas Bldg, Wichita, KS 67202
Character of Well (Completed as Oil, Gas or Dry Hole)

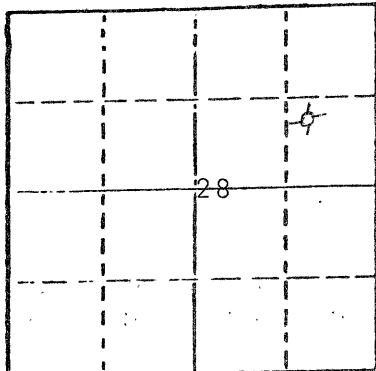

Locate well correctly on above
Section Plat

DRY HOLE
Date Well completed 1/10/78 19
Application for plugging filed 1/10/78 19
Application for plugging approved 1/10/78 19
Plugging commenced 1/10/78 19
Plugging completed 1/10/78 19
Reason for abandonment of well or producing formation

If a producing well is abandoned, date of last production 19

Was permission obtained from the Conservation Division or its agents before plugging was commenced? YES

Name of Conservation Agent who supervised plugging of this well GILBERT BALTHAZOR
Producing formation Depth to top Bottom Total Depth of Well 3890'
Show depth and thickness of all water, oil and gas formations.

OIL, GAS OR WATER RECORDS

CASING RECORD

| FORMATION | CONTENT | FROM | TO | SIZE | PUT IN | PULLED OUT |
|-----------|---------|------|----|--------|---------|------------|
| | | | | 8 5/8" | 254.06' | NONE |

Describe in detail the manner in which the well was plugged, indicating where the mud fluid was placed and the method or methods used in introducing it into the hold. If cement or other plugs were used, state the character of same and depth placed, from feet to feet for each plug set.

FILLED WITH HEAVY MUD TO 1400'.
SET PLUG. PUT IN 70 SACKS CEMENT. FILLED WITH HEAVY MUD TO 240'. SET PLUG. PUT IN 20 SACKS CEMENT. FILLED WITH HEAVY MUD TO 40'. SET PLUG. FILLED TO TOP WITH 10 SACKS 50-50 POZ 6% GEL.

RECEIVED
STATE CORPORATION COMMISSION

JAN 23 1978 123-78

(If additional description is necessary, use BACK of this sheet)
Name of Plugging Contractor C-G DRILLING CO
1107 DOUGLAS BLDG, WICHITA, KS 67202

STATE OF KANSAS COUNTY OF SEDGWICK ss.
G F GALLOWAY (employee of owner) or (owner or operator) of the above-described

well, being first duly sworn on oath, says: That I have knowledge of the facts, statements, and matters herein contained and the log of the above-described well as filed and that the same are true and correct. So help me God.

(Signature) G F GALLOWAY (Address)

Subscribed and Sworn to before me this 16TH day of JANUARY, 1978

My commission expires MARCH 3, 1980

DEBRA L HEERSCHE Notary Public.

