

15-153-20426-00-00

STATE OF KANSAS  
STATE CORPORATION COMMISSION

WELL PLUGGING RECORD


Give All Information Completely  
Make Required Affidavit  
Mail or Deliver Report to  
Conservation Division  
State Corporation Comm.  
245 North Water  
Wichita, KS 67202

Rawlins County. Sec. 2 Twp. 5. S Rge. 31 W  
Location as "NE/CNW 1/4 SW 1/4" or footage from lines 130' N and  
70' E. of SE SW  
Lease Owner S & W Drilling Co.  
Lease Name Brown Well No. 1  
Office Address Box 132 Oberlin, Ks. 67749  
Character of Well (Completed as Oil, Gas or Dry Hole) \_\_\_\_\_

Dry hole  
Date Well completed 9-1-81 19  
Application for plugging filed 9-25-81 19  
Application for plugging approved \_\_\_\_\_ 19  
Plugging commenced 9-2-81 19  
Plugging completed 9-2-81 19  
Reason for abandonment of well or producing formation \_\_\_\_\_

Rotary Dry hole  
If a producing well is abandoned, date of last production \_\_\_\_\_ 19

Was permission obtained from the Conservation Division or its agents before plugging was commenced? yes

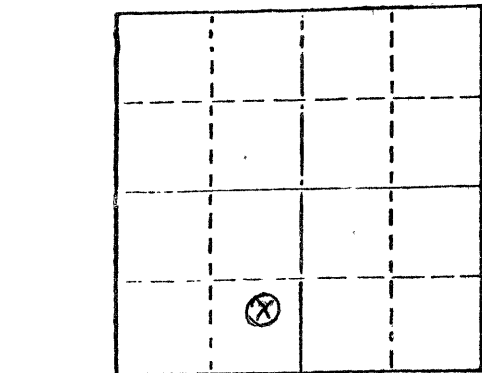

Locate well correctly on above Section Plat

Name of Conservation Agent who supervised plugging of this well Gilbert Balthazer  
Producing formation None Depth to top \_\_\_\_\_ Bottom \_\_\_\_\_ Total Depth of Well 4160  
Show depth and thickness of all water, oil and gas formations.

OIL, GAS OR WATER RECORDS

CASING RECORD

FORMATION	CONTENT	FROM	TO	SIZE	PUT IN	PULLED OUT

Describe in detail the manner in which the well was plugged, indicating where the mud fluid was placed and the method or methods used in introducing it into the hold. If cement or other plugs were used, state the character of same and depth placed, from \_\_\_\_\_ feet to \_\_\_\_\_ feet for each plug set.

A 60 sack plug was set at 1800'  
A 40 sack plug was set @ 210'  
A 10 sack plug was set @ 40' to surface  
5 sacks were placed in the rat hole  
5 sacks were placed in the mouse hole  
All cement was 50/50 Poz w/ 6% gel by Halliburton.

(If additional description is necessary, use BACK of this sheet)

Name of Plugging Contractor Halliburton

STATE OF KANSAS COUNTY OF DECATUR, ss.  
HELEN BEALL (employee of owner) or (owner or operator)

of the above-described well, being first duly sworn on oath, says: That I have knowledge of the facts, statements, and matters herein contained and the log of the above-described well as filed and that the same are true and correct. So help me God.

(Signature) [Signature] **S & W DRILLING COMPANY INC**  
**VICE PRESIDENT**  
BOX 132 OBERLIN, KAN 67749  
(Address)

SUBSCRIBED AND SWORN TO before me this 25<sup>th</sup> day of September, 19 81

[Signature]  
Notary Public.



RECEIVED  
STATE CORPORATION COMMISSION

SEP 28 1981  
9-28-81  
CONSERVATION DIVISION  
Wichita, Kansas