

15-153-20012-06-00


STATE OF KANSAS  
STATE CORPORATION COMMISSION

Form CP-4

WELL PLUGGING RECORD

Give All Information Completely  
Make Required Affidavit  
Mail or Deliver Report to:  
Conservation Division  
State Corporation Commission  
212 No. Market  
Wichita, Kansas

NORTH

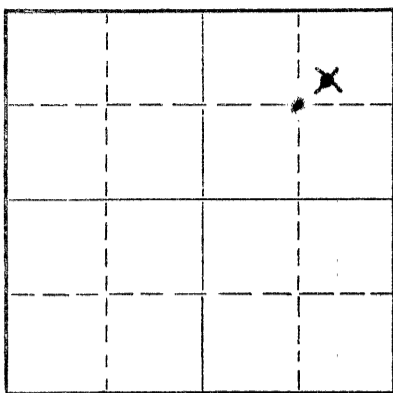

Locate well correctly on above  
Section Plat

Rawlins County. Sec. 8 Twp. 5 Rge. (E) 31 (W)  
Location as "NE/CNW/SW" or footage from lines 110 S. of N. line & 110 W. of E. line  
Lease Owner Marion C. Helberg & D. L. Somers  
Lease Name G. P. Schmahl Well No. 1  
Office Address Morland, Kansas  
Character of Well (completed as Oil, Gas or Dry Hole) dry hole  
Date well completed August 12, 1967 19.67  
Application for plugging filed August 12 19.67  
Application for plugging approved August 12 19.67  
Plugging commenced August 12 19.67  
Plugging completed August 12 1:00 P.M. 19.67  
Reason for abandonment of well or producing formation no oil

If a producing well is abandoned, date of last production 19.  
Was permission obtained from the Conservation Division or its agents before plugging was commenced? yes

Name of Conservation Agent who supervised plugging of this well W. L. Nichols  
Producing formation \_\_\_\_\_ Depth to top \_\_\_\_\_ Bottom \_\_\_\_\_ Total Depth of Well \_\_\_\_\_ Feet  
Show depth and thickness of all water, oil and gas formations.

OIL, GAS OR WATER RECORDS

CASING RECORD

FORMATION	CONTENT	FROM	TO	SIZE	PUT IN	PULLED OUT
See drillers log and	geologist report					

Describe in detail the manner in which the well was plugged, indicating where the mud fluid was placed and the method or methods used in introducing it into the hole. If cement or other plugs were used, state the character of same and depth placed, from \_\_\_\_\_ feet to \_\_\_\_\_ feet for each plug set.

Set plug # 1 at 1620 feet with 80 sacks of cement with Halliburton pump truck, filling to approx. 1380 feet.----- Set plug # 2 at 210 feet with 30 sacks of cement with Halliburton pump truck, filling to approx 120 feet.----- Set plug # 3 at 40 feet with 10 sacks of cement to top of cellar.

RECEIVED  
STATE CORPORATION COMMISSION  
AUG 16 1967

CONSERVATION DIVISION  
Wichita, Kansas

8-16-67

(If additional description is necessary, use BACK of this sheet)

Name of Plugging Contractor Company (Helberg Oil Company)  
Address Morland, Kansas


STATE OF Kansas, COUNTY OF Graham, ss.

Jerry M. Helberg (employee of owner) or (owner or operator) of the above-described well, being first duly sworn on oath, says: That I have knowledge of the facts, statements, and matters herein contained and the log of the above-described well as filed and that the same are true and correct. So help me God.

(Signature) Jerry M. Helberg  
Morland, Kansas (Address)

SUBSCRIBED AND SWORN TO before me this 15th day of August, 1967

My commission expires \_\_\_\_\_

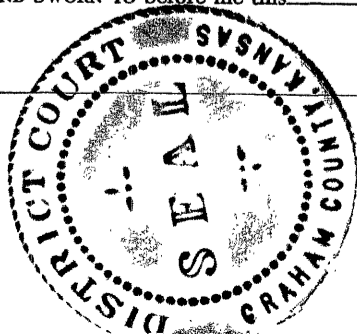

Margaret A. Thebeand  
Notary Public  
Clerk of the Dist. Court