


STATE OF KANSAS  
STATE CORPORATION COMMISSION

Give All Information Completely  
Make Required Affidavit  
Mail or Deliver Report to:  
Conservation Division  
State Corporation Commission  
212 North Market, Insurance Bldg.  
Wichita, Kansas

15-153-30163-00-00  
WELL PLUGGING RECORD

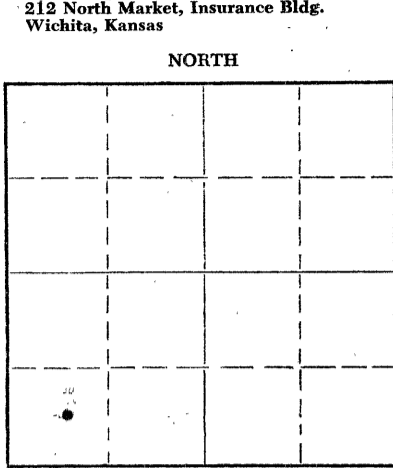

Locate well correctly on above Section Plat

Rawlins County. Sec. 4 Twp. 5S Rge. (E) 31 (W)  
Location as "NE/CNW%SW%" or footage from lines C-SW-SW  
Lease Owner Amerada Petroleum Corporation  
Lease Name G.W. Chance Well No. 1  
Office Address Box 197, Great Bend, Kansas  
Character of Well (completed as Oil, Gas or Dry Hole) Dry Hole  
Date well completed 5-14- 1961  
Application for plugging filed 5-14- 1961  
Application for plugging approved 5-14- 1961  
Plugging commenced 12:45 AM 5-14- 1961  
Plugging completed 2:30 AM 5-14- 1961  
Reason for abandonment of well or producing formation Dry Hole

If a producing well is abandoned, date of last production = 19    
Was permission obtained from the Conservation Division or its agents before plugging was commenced? Yes.

Name of Conservation Agent who supervised plugging of this well A.D. Fabricius  
Producing formation = Depth to top = Bottom = Total Depth of Well 4215 Feet  
Show depth and thickness of all water, oil and gas formations.

OIL, GAS OR WATER RECORDS

CASING RECORD

FORMATION	CONTENT	FROM	TO	SIZE	PUT IN	PULLED OUT
				8-5/8"	207'	None

Describe in detail the manner in which the well was plugged, indicating where the mud fluid was placed and the method or methods used in introducing it into the hole. If cement or other plugs were used, state the character of same and depth placed, from    feet to    feet for each plug set.  
Filled hole with heavy mud to 400'.  
Spotted cement plug from 400' to 335' with 20 sacks cement.  
Filled hole with heavy mud to 210'.  
Spotted cement plug from 210' to 139' with 20 sacks cement.  
Filled hole with heavy mud from 139' to 40'.  
Spotted cement plug from 40' to top of cellar with 15 sacks cement.  
Started plugging at 12:45 AM, Finished at 2:30 AM 5-15-61.

RECEIVED  
STATE CORPORATION COMMISSION  
MAY 18 1961  
CONSERVATION DIVISION  
Wichita, Kansas

(If additional description is necessary, use BACK of this sheet)  
Name of Plugging Contractor Jelly Reaves Drilling Company  
Address Box 1264, Cushing, Oklahoma

STATE OF Kansas, COUNTY OF Barton, ss.  
A.D. Simpson (employee of owner) or (owner) or (operator) of the above-described well, being first duly sworn on oath, says: That I have knowledge of the facts, statements, and matters herein contained and the log of the above-described well as filed and that the same are true and correct. So help me God.

(Signature) A.D. Simpson  
Box 197, Great Bend, Kansas  
(Address)

SUBSCRIBED AND SWORN TO before me this 16th day of May, 19 61

My commission expires November 21, 1961  
Charles W. Anderson Notary Public.



15-153-30163-00-00

G.W. CHANCE NO. 1  
C-SW/4-SW/4  
Section 4-5S-31W

DRILLER'S LOG:

<u>From</u>	<u>To</u>	
0'	150'	Sand
150'	2440'	Shale
2440'	2455'	Lime
2455'	3430'	Shale
3430'	3440'	Lime
3440'	3490'	Shale
3490'	3675'	Lime
3675'	3776'	Shale
3776'	3789'	Sand
3789'	3800'	Shale
3800'	4215'	Lime
	4215'	T.D.

6 Jts. 8-5/8" OD 24# 8RT J55 R2 SS API Casing ST&C, New Set @ 207'.  
Completed as Dry Hole.

**RECEIVED**  
STATE CORPORATION COMMISSION

MAY 18 1961

CONSERVATION DIVISION  
Wichita, Kansas

5-18-61